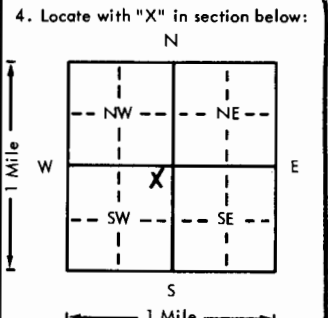
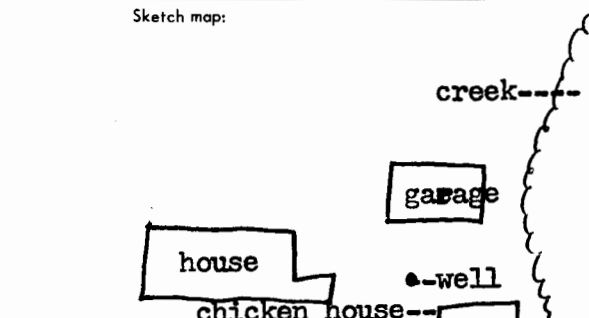


USE TYPEWRITER OR BALL POINT PEN-PRESS FIRMLY, PRINT CLEARLY.

WATER WELL RECORD
KSA 82a-1201-1215

Kansas Department of Health and Environment-Division of Environment
(Water well Contractors)
Topeka, Kansas 66620

1. Location of well:	County Russell	Fraction NE 1/4 NE 1/4 SW 1/4	Section number 31	Township number T 11 S	Range number R 15	XX/W		
2. Distance and direction from nearest town or city: Street address of well location if in city: Fairport, Ks.			3. Owner of well: Lloyd Oswald R.R. or street: Fairport, Ks. City, state, zip code:					
4. Locate with "X" in section below: 		Sketch map: 		6. Bore hole dia 9 in. Completion date 12-18-79 Well depth 80 ft.				
5. Type and color of material		From		To		7. <input type="checkbox"/> Cable tool <input checked="" type="checkbox"/> Rotary <input type="checkbox"/> Driven <input type="checkbox"/> Dug <input type="checkbox"/> Hollow rod <input type="checkbox"/> Jetted <input type="checkbox"/> Bored <input type="checkbox"/> Reverse rotary		
		topsoil		0		6		8. Use: <input checked="" type="checkbox"/> Domestic <input type="checkbox"/> Public supply <input type="checkbox"/> Industry <input type="checkbox"/> Irrigation <input type="checkbox"/> Air conditioning <input type="checkbox"/> Stock <input type="checkbox"/> Lawn <input type="checkbox"/> Oil field water <input type="checkbox"/> Other
		sandy clay		6		45		9. Casing: Material pvc Height: Above or below Threaded <input type="checkbox"/> Welded <input checked="" type="checkbox"/> Surface 14 in. RMP <input type="checkbox"/> PVC <input checked="" type="checkbox"/> Weight 200 lbs./ft. Dia 5 in. to 80 ft. depth Wall thickness .26 inches or Dia. <input type="checkbox"/> in. to <input type="checkbox"/> ft. depth Gage No. .26
		sand and clay		45		58		10. Screen jet stream Type pvc Dia. 5 Slot/gage .031 Length 20 Set between 60 ft. and 80 ft. ft. and <input type="checkbox"/> ft. Gravel pack? <input checked="" type="checkbox"/> Size range of material 1/2-2
		medium to coarse sand		58		76		11. Static water level: 50 ft. below land surface Date 12-18-79
		blue shale		76		80		12. Pumping level below land surfaces: 50 ft. after 1 hrs. pumping 25 g.p.m. <input type="checkbox"/> ft. after <input type="checkbox"/> hrs. pumping <input type="checkbox"/> g.p.m. Estimated maximum yield 25 g.p.m.
						13. Water sample submitted: <input type="checkbox"/> Yes <input checked="" type="checkbox"/> No Date		
						14. Well head completion: <input checked="" type="checkbox"/> Pitless adapter <input type="checkbox"/> _____ Inches above grade		
						15. Well grouted? <input checked="" type="checkbox"/> With: <input checked="" type="checkbox"/> Neat cement <input type="checkbox"/> Bentonite <input type="checkbox"/> Concrete Depth: From 4 ft. to 14 ft.		
						16. Nearest source of possible contamination: 300 ft. Direction west Type creek Well disinfected upon completion? <input checked="" type="checkbox"/> Yes <input type="checkbox"/> No		
						17. Pump: F&W Not installed Manufacturer's name F&W Model number 10bk9 HP 1 Volts 220 Length of drop pipe 70 ft. capacity 19 g.p.m. Type: <input checked="" type="checkbox"/> Submersible <input type="checkbox"/> Turbine <input type="checkbox"/> Jet <input type="checkbox"/> Reciprocating <input type="checkbox"/> Centrifugal <input type="checkbox"/> Other		
18. Elevation:		19. Remarks:		20. Water well contractor's certification: This well was drilled under my jurisdiction and this report is true to the best of my knowledge and belief. Karst Water Well 199 Business name E. Hway 40 Hays, Ks. License No. 12-18-79 Address MB Karst Signed MB Karst Authorized representative Date 12-18-79				

T 11 R 15 Sec 31 NE 1/4 SW

Forward the white, blue and pink copies to the Department of Health and Environment

Form WWC-5