


1 LOCATION OF WATER WELL: County: <b>Shawnee</b>	Fraction NW ¼ SW ¼ SE ¼	Section Number <b>17</b>	Township Number T <b>11</b> S	Range Number R <b>16</b> <b>E/W</b>
---	----------------------------	-----------------------------	----------------------------------	--

Distance and direction from nearest town or city street address of well if located within city?  
**101 NE US 24, Topeka**

2 WATER WELL OWNER: **Greenfield Environmental Multistate Trust LLC**  
 RF#, St. Address, Box # : **1920 232nd Place SE** Board of Agriculture, Division of Water Resources  
 City, State, ZIP Code : **Bothell, WA 98021** Application Number:

3 LOCATE WELL'S LOCATION WITH AN "X" IN SECTION BOX:

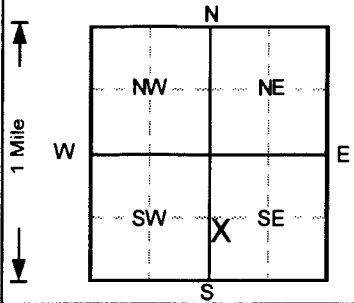

4 DEPTH OF COMPLETED WELL: **30** ft ELEVATION: \_\_\_\_\_  
 Depth(s) Groundwater Encountered 1. **5.5** ft 2. \_\_\_\_\_ ft 3. \_\_\_\_\_ ft  
 WELL'S STATIC WATER LEVEL \_\_\_\_\_ ft below land surface measured on mo/day/yr \_\_\_\_\_  
 Pump test data: Well water was **NA** ft after \_\_\_\_\_ hours pumping \_\_\_\_\_ gpm  
 Est. Yield **NA** gpm: Well water was \_\_\_\_\_ ft after \_\_\_\_\_ hours pumping \_\_\_\_\_ gpm  
 Bore Hole Diameter **8** in. to **35** ft, and \_\_\_\_\_ in. to \_\_\_\_\_ ft  
 WELL WATER TO BE USED AS:  
 5 Public water supply 8 Air conditioning 11 Injection well  
 1 Domestic 3 Feedlot 6 Oil field water supply 9 Dewatering 12 Other (Specify below)  
 2 Irrigation 4 Industrial 7 Lawn and garden only **10** Monitoring well  
 Was a chemical/bacteriological sample submitted to Department? Yes \_\_\_\_\_ No  ; If yes, mo/day/yr sample was submitted  
 Water Well Disinfected? Yes \_\_\_\_\_ No

5 TYPE OF BLANK CASING USED:  
 1 Steel 3 RMP (SR) 5 Wrought iron 8 Concrete tile CASING JOINTS: Glued \_\_\_\_\_ Clamped \_\_\_\_\_  
**2** PVC 4 ABS 6 Asbestos-Cement 9 Other (specify below) Welded \_\_\_\_\_  
 7 Fiberglass Threaded   
 Blank casing diameter **2** in. to **10** ft, Dia \_\_\_\_\_ in. to \_\_\_\_\_ ft, Dia \_\_\_\_\_ in. to \_\_\_\_\_ ft  
 Casing height above land surface \_\_\_\_\_ in., weight \_\_\_\_\_ lbs./ft. Wall thickness or gauge No. **Sch. 40**  
 TYPE OF SCREEN OR PERFORATION MATERIAL  
 1 Steel 3 Stainless steel 5 Fiberglass **7** PVC 10 Asbestos-cement  
 2 Brass 4 Galvanized steel 6 Concrete tile 8 RMP (SR) 11 Other (specify) \_\_\_\_\_  
 9 ABS 12 None used (open hole)  
 SCREEN OR PERFORATION OPENINGS ARE:  
 1 Continuous slot **3** Mill slot 5 Gauzed wrapped 8 Saw cut 11 None (open hole)  
 2 Louvered shutter 4 Key punched 6 Wire wrapped 9 Drilled holes  
 7 Torch cut 10 Other (specify) \_\_\_\_\_  
 SCREEN-PERFORATED INTERVALS: From **10** ft to **30** ft, From \_\_\_\_\_ ft to \_\_\_\_\_ ft  
 From \_\_\_\_\_ ft to \_\_\_\_\_ ft, From \_\_\_\_\_ ft to \_\_\_\_\_ ft  
 GRAVEL PACK INTERVALS: From **8** ft to **35** ft, From \_\_\_\_\_ ft to \_\_\_\_\_ ft  
 From \_\_\_\_\_ ft to \_\_\_\_\_ ft, From \_\_\_\_\_ ft to \_\_\_\_\_ ft

6 GROUT MATERIAL: 1 Neat cement 2 Cement grout **3** Bentonite **4** Other Concrete \_\_\_\_\_  
 Grout Intervals: From **0** ft to **1** ft, From **1** ft to **8** ft, From \_\_\_\_\_ ft to \_\_\_\_\_ ft  
 What is the nearest source of possible contamination:  
 1 Septic tank 4 Lateral lines 7 Pit privy 10 Livestock pens 14 Abandoned water well  
 2 Sewer lines 5 Cess pool 8 Sewage lagoon 11 Fuel storage 15 Oil well/Gas well  
 3 Watertight sewer lines 6 Seepage pit 9 Feedyard 12 Fertilizer storage 16 Other (specify below)  
 13 Insecticide storage  
 Direction from well? \_\_\_\_\_ How many feet? \_\_\_\_\_

FROM	TO	LITHOLOGIC LOG	FROM	TO	PLUGGING INTERVALS
0	5	Clay,			
5	6	Clay, Brown			
6	10	Silt, Brown Gray			
10	10.8	Silt, with clay, Dark Brown			
10.8	15	Silt, Brown Gray			
15	18.25	Silt, w/clay, incr. w/depth, Brown Gray			
18.25	20	Sand, m, Brown Gray			
20	21	Sand, m, Lt. Brown			
21	22.5	Sand, f, Lt. Brown			
22.5	28.25	Sand, coarsens w/depth, Lt. Brown			
28.25	28.5	Clay, Dark Brown			
28.5	32.5	Clay, Dark Brown			
32.5	35	Sand, c, Dark Brown			MW-15

7 CONTRACTOR'S OR LANDOWNER'S CERTIFICATION: This water well was **1** constructed, (2) reconstructed, or (3) plugged under my jurisdiction and was completed on (mo/day/year) **11/11/2015** and this record is true to the best of my knowledge and belief.  
 Kansas Water Well Contractor's License No. **527** This Water Well Record was completed on (mo/day/yr) **2/1/16**  
 under the business name of **GeoCore, Inc.** by (signature) *Don Holt*