USE TYPEWRITER OR BALL POINT PEN-PRESS FIRMLY, PRINT CLEARLY.

T R EW sec 1/4 1/4 1/4 No.

WATER WELL RECORD
KSA 82a-1201-1215

Kansas State Dept. Of Health
(Water Well Contractors)
Forbes-Bldg. 740
Topeka, Kansas 66620

NE¼ SW¼ NE¼

1 Location of well:	County	Township name	Fraction	Section number	Town number	Range number
	ELLIS	CATHERINE	~~NE¼ SW¼ NE¼~~	16	11S	17W

Distance and direction from nearest town or city: 10M SOUTH

Street address of well location if in city: 4½ EAST OF PLAINVILLE KS.

3 Owner of well: ROSS BEACH

Address: PLAINVILLE KANS. RR#2

Locate with "X" in section below:

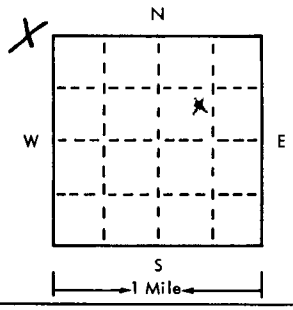

Sketch map:

4 Well depth: 30 ft. Date of completion 12/11/78
Well diameter 12 in.

5 ☐ Cable tool ☒ Rotary ☐ Driven ☐ Dug ☐ Hollow rod ☐ Jetted ☐ Bored ☐ Reverse rotary

6 Use: ☒ Domestic ☐ Public supply ☐ Industry ☐ Irrigation ☐ Air conditioning ☐ Commercial ☐ Test well ☐

7 Casing: Material PVC
Threaded ☐ Welded ☐
Diam. 6 in. to 30 ft. depth
___ in. to ___ ft. depth
Height: above/below Surface 24 in.
Weight 200 lbs./ft.
Drive shoe? ☐ Yes ☒ No

2

Type and color of material	From	To
TOP SOIL	0	5
SAND	5	28
BLUE SHALE	28	30