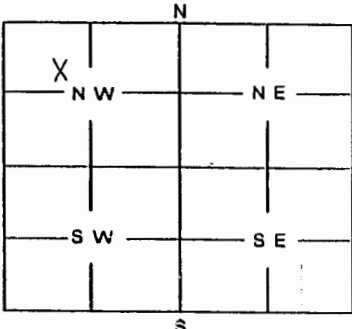


1	LOCATION OF WATER WELL: County: <u>Ellis</u>	Fraction <u>SE 1/4 NW 1/4 NW 1/4</u>	Section Number <u>17</u>	Township Number <u>11 S</u>	Range Number <u>17 W</u>
---	---	---	-----------------------------	--------------------------------	-----------------------------

Distance and direction from nearest town or city street address of well if located within city?  
14 mi. N, 3.5 mi. E, then 1/4 mi. S of Hays, Kansas

2	WATER WELLOWNER: <u>NCRA</u> RR #, St. Address, Box #: <u>P.O. Box 1401</u> City, State, ZIP Code: <u>McPherson, KS 67460</u>	Board of Agriculture, Division of Water Resources Application Number:
---	---	--

3	MARK WELL'S LOCATION WITH AN "X" IN SECTION BOX: 	4	DEPTH OF WELL <u>25</u> ft. WELL'S STATIC WATER LEVEL _____ ft. WELL WAS USED AS: 1 Domestic      5 Public Water Supply      9 Dewatering 2 Irrigation      6 Oil Field Water Supply      10 Monitoring Well 3 Feedlot      7 Domestic (Lawn & Garden)      11 Injection Well 4 Industrial      8 Air Conditioning      12 Other _____ Was a chemical / bacteriological sample submitted to Department? Yes _____ No <input checked="" type="checkbox"/> If yes, mo/day/yr sample was submitted _____ Water Well Disinfected: Yes _____ No <input checked="" type="checkbox"/>
---	---	---	---

5	TYPE OF BLANK CASING USED: 1 Steel      3 RMP (SR)      5 Wrought      7 Fiberglass      9 Other (Specify below) 2 PVC      4 ABS      6 Asbestos-Cement      8 Concrete Tile Blank casing diameter <u>2</u> in.      Was casing pulled? Yes _____ No <input checked="" type="checkbox"/> If yes, how much <u>to 20'</u> Casing height above or below land surface <u>n/a</u> in.
---	---

6	GROUT PLUG MATERIAL: 1 Neat cement      2 Cement grout      3 Bentonite      4 Other _____ Grout Plug Intervals: From <u>0</u> ft. to <u>25</u> ft.      From _____ ft. to _____ ft.      From _____ ft. to _____ ft. What is the nearest source of possible contamination: 1 Septic tank      6 Seepage pit      11 Fuel storage      16 Other (specify below) <u>crude oil pipeline</u> 2 Sewer lines      7 Pit privy      12 Fertilizer storage 3 Watertight sewer lines      8 Sewage lagoon      13 Insecticide storage 4 Lateral lines      9 Feedyard      14 Abandoned water well 5 Cess Pool      10 Livestock pens      15 Oil well/Gas well Direction from well? <u>South</u> How many feet? <u>135</u>
---	---

FROM	TO	PLUGGING MATERIALS
<u>0</u>	<u>20</u>	<u>Bentonite (8")</u>
<u>20</u>	<u>25</u>	<u>Bentonite (2")</u>

7	CONTRACTOR'S OR LANDOWNER'S CERTIFICATION: This water well was plugged under my jurisdiction and was completed on (mo/day/year) _____ and this record is true to the best of my knowledge and belief. Kansas Water Well Contractor's License No. <u>527</u> This Water Well Record was completed on (mo/day/year) <u>2-17-2004</u> under the business name of <u>Geo Core Inc.</u> by (signature) <u>Steve A. Hill</u>
---	---

INSTRUCTIONS: Use typewriter or ball point pen. Please press firmly and print clearly. Please fill in blanks, underline or circle the correct answers. Send top three copies to Kansas Department of Health and Environment, Bureau of Water, Topeka, Kansas 66620-0001. Telephone: 785/296-3565. Send one to Water Well Owner and retain one for your records.