


WATER WELL RECORD Form WWC-5 KSA 82a-1212

1 LOCATION OF WATER WELL: Fraction NW 1/4 NW 1/4 NE 1/4 Section Number 29 Township Number T 11 S Range Number R 18 ~~W~~

Distance and direction from nearest town or city street address of well if located within city?  
10 miles north of Hays, Kansas

2 WATER WELL OWNER: Dan Johnson  
RR#, St. Address, Box #: P.O. Box 247  
City, State, ZIP Code: Hays, Kansas 67601  
Board of Agriculture, Division of Water Resources  
Application Number:

3 LOCATE WELL'S LOCATION WITH AN "X" IN SECTION BOX:  
4 DEPTH OF COMPLETED WELL: 63 ft. ELEVATION: Valley  
Depth(s) Groundwater Encountered 1. 45 ft. 2. ft. 3. ft.  
WELL'S STATIC WATER LEVEL: 43 ft. below land surface measured on mo/day/yr 7/5/90  
Pump test data: Well water was 49 ft. after 8 hours pumping 100 gpm  
Est. Yield 100 gpm: Well water was ft. after hours pumping gpm  
Bore Hole Diameter: 10 in. to 63 ft., and in. to ft.  
WELL WATER TO BE USED AS: 1 5 Public water supply 8 Air conditioning 11 Injection well  
2 Irrigation 3 Feedlot 6 Oil field water supply 9 Dewatering 12 Other (Specify below)  
Was a chemical/bacteriological sample submitted to Department? Yes No  If yes, mo/day/yr sample was submitted  
Water Well Disinfected? Yes  No

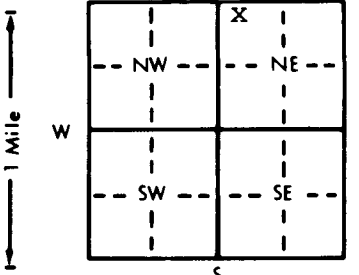

5 TYPE OF BLANK CASING USED: 2 5 Wrought iron 8 Concrete tile CASING JOINTS: Glued  Clamped  
1 Steel 3 RMP (SR) 6 Asbestos-Cement 9 Other (specify below) Welded  
2 PVC 4 ABS 7 Fiberglass Threaded  
Blank casing diameter 5 in. to 43 ft., Dia. in. to ft., Dia. in. to ft.  
Casing height above land surface 24 in., weight 2.29 lbs./ft. Wall thickness or gauge No. 26  
TYPE OF SCREEN OR PERFORATION MATERIAL: 7 7 PVC 10 Asbestos-cement  
1 Steel 3 Stainless steel 5 Fiberglass 8 RMP (SR) 11 Other (specify)  
2 Brass 4 Galvanized steel 6 Concrete tile 9 ABS 12 None used (open hole)  
SCREEN OR PERFORATION OPENINGS ARE: 8 5 Gauzed wrapped 8 Saw cut 11 None (open hole)  
1 Continuous slot 3 Mill slot 6 Wire wrapped 9 Drilled holes  
2 Louvered shutter 4 Key punched 7 Torch cut 10 Other (specify)  
SCREEN-PERFORATED INTERVALS: From 43 ft. to 63 ft., From ft. to ft.  
GRAVEL PACK INTERVALS: From 25 ft. to 63 ft., From ft. to ft.  
From ft. to ft., From ft. to ft.

6 GROUT MATERIAL: 1 1 Neat cement 2 Cement grout 3 Bentonite 4 Other  
Grout Intervals: From 5 ft. to 25 ft., From ft. to ft., From ft. to ft.  
What is the nearest source of possible contamination: None  
1 Septic tank 4 Lateral lines 7 Pit privy 10 Livestock pens 14 Abandoned water well  
2 Sewer lines 5 Cess pool 8 Sewage lagoon 11 Fuel storage 15 Oil well/Gas well  
3 Watertight sewer lines 6 Seepage pit 9 Feedyard 12 Fertilizer storage 16 Other (specify below)  
13 Insecticide storage

Direction from well?		LITHOLOGIC LOG	How many feet?		PLUGGING INTERVALS
FROM	TO		FROM	TO	
0	3	Topsoil			
3	15	Loose rock and gumbo			
15	45	Loose rock and sand			
45	47	Rock			
47	58	Loose shale sand and mud layers			
58	63	Shale			

7 CONTRACTOR'S OR LANDOWNER'S CERTIFICATION: This water well was (1) constructed, (2) reconstructed, or (3) plugged under my jurisdiction and was completed on (mo/day/year) 7/5/90 and this record is true to the best of my knowledge and belief. Kansas Water Well Contractor's License No. 199 This Water Well Record was completed on (mo/day/yr) 10/23/90 under the business name of Karst Water Well Drilling & Service, Inc. by (signature)

INSTRUCTIONS: Use typewriter or ball point pen. PLEASE PRESS FIRMLY and PRINT clearly. Please fill in blanks, underline or circle the correct answers. Send top three copies to Kansas Department of Health and Environment, Bureau of Water, Topeka, Kansas 66620-7320. Telephone: 913-296-5545. Send one to WATER WELL OWNER and retain one for your records.

OFFICE USE ONLY  
T  
R  
EW  
SEC.  
1/4  
1/4  
1/4