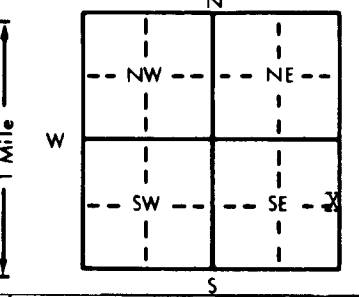


1 LOCATION OF WATER WELL: County: <u>Ellis</u>	Fraction <u>SE</u> ¼ <u>NE</u> ¼ <u>SE</u> ¼	Section Number <u>20</u>	Township Number T <u>11</u> S	Range Number R <u>19W</u> E/W
---	---	-----------------------------	----------------------------------	----------------------------------

Distance and direction from nearest town or city street address of well if located within city?
9 1/2 N, 1 W Of I-70 and Yocemento, Ks.

2 WATER WELL OWNER: <u>William Hagen</u>	<u>Red Tiger Drilling</u>	<u>Hagen No. 1-20</u>
RR#, St. Address, Box # : <u>Ellis, Kansas</u>	<u>1720 Ks. St. Bank Bldg.</u>	Board of Agriculture, Division of Water Resources
City, State, ZIP Code : <u>67637</u>	<u>Wichita, Ks. 67202</u>	Application Number: <u>T84-402</u>

3 LOCATE WELL'S LOCATION WITH AN "X" IN SECTION BOX: 	4 DEPTH OF COMPLETED WELL... <u>65</u> ft. ELEVATION: <u>Unknown</u>
	Depth(s) Groundwater Encountered <u>1.20</u> ft. 2. ft. 3. ft.
WELL'S STATIC WATER LEVEL <u>20</u> ft. below land surface measured on mo/day/yr <u>7/9/84</u>	
Pump test data: Well water was ft. after hours pumping gpm	
Est. Yield ... <u>60</u> gpm: Well water was ft. after hours pumping gpm	
Bore Hole Diameter..... <u>8</u> in. to <u>65</u> ft., and in. to ft.	
WELL WATER TO BE USED AS: 5 Public water supply 8 Air conditioning 11 Injection well	
1 Domestic 3 Feedlot 6 <u>Oil field water supply</u> 9 Dewatering 12 Other (Specify below)	
2 Irrigation 4 Industrial 7 Lawn and garden only 10 Observation well	
Was a chemical/bacteriological sample submitted to Department? Yes..... <u>No</u>; If yes, mo/day/yr sample was submitted	
Water Well Disinfected? Yes <u>No</u>	

5 TYPE OF BLANK CASING USED:	5 Wrought iron	8 Concrete tile	CASING JOINTS: <u>Glued</u> Clamped
1 Steel	3 RMP (SR)	6 Asbestos-Cement	9 Other (specify below)
2 <u>PVC</u>	4 ABS	7 Fiberglass
Blank casing diameter <u>5</u> in. to <u>45</u> ft., Dia in. to ft., Dia in. to ft.	Casing height above land surface..... <u>12</u> in., weight <u>2.8</u> lbs./ft. Wall thickness or gauge No. <u>Sch. 40</u>		
TYPE OF SCREEN OR PERFORATION MATERIAL:		7 <u>PVC</u>	10 Asbestos-cement
1 Steel	3 Stainless steel	5 Fiberglass	8 RMP (SR)
2 Brass	4 Galvanized steel	6 Concrete tile	9 ABS
SCREEN OR PERFORATION OPENINGS ARE:		5 Gauzed wrapped	8 <u>Saw cut</u>
1 Continuous slot	3 Mill slot	6 Wire wrapped	9 Drilled holes
2 Louvered shutter	4 Key punched	7 Torch cut	10 Other (specify)
SCREEN-PERFORATED INTERVALS: From <u>45</u> ft. to <u>65</u> ft., From ft. to ft.		11 None used (open hole)	
GRAVEL PACK INTERVALS: From <u>10</u> ft. to <u>65</u> ft., From ft. to ft.		12 None used (open hole)	

6 GROUT MATERIAL:	1 Neat cement	2 Cement grout	3 <u>Bentonite</u>	4 Other
Grout Intervals: From ... <u>0</u> ft. to <u>10</u> ft., From ft. to ft., From ft. to ft.	What is the nearest source of possible contamination:			
1 Septic tank	4 Lateral lines	7 Pit privy	10 Livestock pens	14 Abandoned water well
2 Sewer lines	5 Cess pool	8 Sewage lagoon	11 Fuel storage	15 <u>Oil well/Gas well</u>
3 Watertight sewer lines	6 Seepage pit	9 Feedyard	12 Fertilizer storage	16 Other (specify below)
Direction from well? <u>South</u>	How many feet? <u>60</u>			

FROM	TO	LITHOLOGIC LOG	FROM	TO	LITHOLOGIC LOG
0	20	Clay			
20	65	Sand and Gravel			

7 CONTRACTOR'S OR LANDOWNER'S CERTIFICATION: This water well was (1) constructed, (2) reconstructed, or (3) plugged under my jurisdiction and was completed on (mo/day/year) 7/9/84 and this record is true to the best of my knowledge and belief. Kansas Water Well Contractor's License No. 186. This Water Well Record was completed on (mo/day/yr) 8/30/84 under the business name of Kellys Water Well Service by (signature) Deanna

INSTRUCTIONS: Use typewriter or ball point pen, PLEASE PRESS FIRMLY and PRINT clearly. Please fill in blanks, underline or circle the correct answers. Send top three copies to Kansas Department of Health and Environment, Division of Environment, Environmental Geology Section, Topeka, KS 66620. Send one to WATER WELL OWNER and retain one for your records.