


1 LOCATION OF WATER WELL: Fraction SE 1/4 SE 1/4 SE 1/4 Section Number 4 Township Number T 11 S Range Number R 19 E/W
 County: Ellis

Distance and direction from nearest town or city street address of well if located within city?
From I-70 & 183: 14 miles north, 6 miles west, 1 mile north, 1/2 mile west

2 WATER WELL OWNER: Robert Schonhaler
 RR#, St. Address, Box # : 1942 250th Ave Board of Agriculture, Division of Water Resources
 City, State, ZIP Code : Hays KS 67601 Application Number:

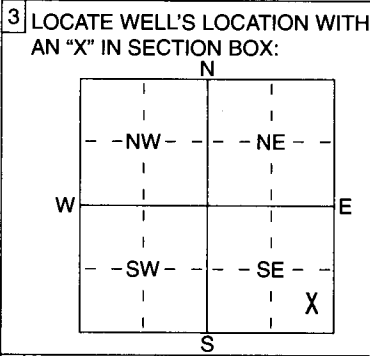

4 DEPTH OF COMPLETED WELL 105 ft. ELEVATION:
 Depth(s) Groundwater Encountered 1 5 ft. 2 ft. 3 ft.
 WELL'S STATIC WATER LEVEL 54 ft. below land surface measured on 8/8/03
 Pump test data: Well water was 54 ft. after 2 hours pumping 15 gpm
 Est. Yield 15 gpm: Well water was ft. after hours pumping gpm
 WELL WATER TO BE USED AS: 1 5 Public water supply 8 Air conditioning 11 Injection well
 2 Irrigation 3 Feedlot 6 Oil field water supply 9 Dewatering 12 Other (Specify below)
 Was a chemical/bacteriological sample submitted to Department? Yes No X ; If yes, mo/day/yr sample was submitted
 Water Well Disinfected? Yes X No

5 TYPE OF BLANK CASING USED: 2 Wrought iron 8 Concrete tile CASING JOINTS: Glued X Clamped
 1 Steel 3 RMP (SR) 6 Asbestos-Cement 9 Other (specify below) Welded
 2 PVC 4 ABS 7 Fiberglass Threaded
 Blank casing diameter 5 in. to 45 ft., Dia in. to ft., Dia in. to ft.
 Casing height above land surface 24 in., weight 2.91 lbs./ft. Wall thickness or gauge No. 21
 TYPE OF SCREEN OR PERFORATION MATERIAL: 7 PVC 10 Asbestos-Cement
 1 Steel 3 Stainless Steel 5 Fiberglass 8 RMP (SR) 11 Other (Specify)
 2 Brass 4 Galvanized Steel 6 Concrete tile 9 ABS 12 None used (open hole)
 SCREEN OR PERFORATION OPENINGS ARE: 8 5 Gauzed wrapped 8 Saw cut 11 None (open hole)
 1 Continuous slot 3 Mill slot 6 Wire wrapped 9 Drilled holes
 2 Louvered shutter 4 Key punched 7 Torch cut 10 Other (specify) ft.
 SCREEN-PERFORATED INTERVALS: From 105 ft. to 45 ft., From ft. to ft.
 GRAVEL PACK INTERVALS: From 20 ft. to 105 ft., From ft. to ft.
 From ft. to ft., From ft. to ft.

6 GROUT MATERIAL: 3 1 Neat cement 2 Cement grout 3 Bentonite 4 Other
 Grout Intervals: From 0 ft. to 20 ft., From ft. to ft., From ft. to ft.
 What is the nearest source of possible contamination:
 1 Septic tank 4 Lateral lines 7 Pit privy 10 Livestock pens 14 Abandoned water well
 2 Sewer lines 5 Cess pool 8 Sewage lagoon 11 Fuel storage 15 Oil well/Gas well
 3 Watertight sewer lines 6 Seepage pit 9 Feedyard 12 Fertilizer storage 16 Other (specify below)
 13 Insecticide storage
 Direction from well? How many feet?

FROM	TO	LITHOLOGIC LOG	FROM	TO	PLUGGING INTERVALS
0	5	Topsoil and clay			
5	15	sand			
15	25	Weathered shale			
25	65	Limestone			
65	70	Dark brown clay			
70	95	Limestone and dark shale			
95	105	Black shale			

7 CONTRACTOR'S OR LANDOWNER'S CERTIFICATION: This water well was (1) constructed, (2) reconstructed, or (3) plugged under my jurisdiction and was completed on (mo/day/year) 9/5/03 and this record is true to the best of my knowledge and belief. Kansas
 Water Well Contractor's Licence No 169 This Water Well Record was completed on (mo/day/yr) 9/9/03
 under the business name of Karst Water Well Drilling & Service, Inc. by (signature) Mel Karst

INSTRUCTIONS: Use typewriter or ball point pen. PLEASE PRESS FIRMLY and PRINT clearly. Please fill in blanks, underline or circle the correct answers. Send top three copies to Kansas Department of Health and Environment, Bureau of Water, Geology Section, 1000 SW Jackson St., Suite 420, Topeka, Kansas 66612-1367. Telephone 785-296-5522. Send one to WATER WELL OWNER and retain one for your records. Fee of \$5.00 for each constructed well.