


1 LOCATION OF WATER WELL: County: Ottawa Fraction SW NE 1/4 NE 1/4 Section Number 18 Township Number T 11 S Range Number R 2 E/W

Distance and direction from nearest town or city street address of well if located within city?

5 miles North & 1 mile East of Bennington, KS

2 WATER WELL OWNER: Wes McArthur Board of Agriculture, Division of Water Resources  
 RR#, St. Address, Box # : 3 McArthur Lane Application Number: N/A  
 City, State, ZIP Code : Salina, KS 67401

3 LOCATE WELL'S LOCATION WITH AN "X" IN SECTION BOX: 4 DEPTH OF COMPLETED WELL... 60 ft. ELEVATION:

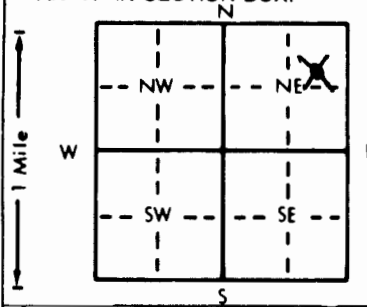

Depth(s) Groundwater Encountered 1. .... ft. 2. .... ft. 3. .... ft.  
 WELL'S STATIC WATER LEVEL ... 13 ... ft. below land surface measured on mo/day/yr ... 4/1/97  
 Pump test data: Well water was ... ft. after ... hours pumping ... gpm  
 Est. Yield ... 15 ... gpm: Well water was ... ft. after ... hours pumping ... gpm  
 Bore Hole Diameter ... 8 ... in. to ... 60 ... ft., and ... in. to ... ft.  
 WELL WATER TO BE USED AS: 5 Public water supply 8 Air conditioning 11 Injection well  
 Domestic 3 Feedlot 6 Oil field water supply 9 Dewatering 12 Other (Specify below)  
 2 Irrigation 4 Industrial 7 Lawn and garden only 10 Monitoring well  
 Was a chemical/bacteriological sample submitted to Department? Yes.....No.....; If yes, mo/day/yr sample was submitted  
 Water Well Disinfected? Yes  No

5 TYPE OF BLANK CASING USED: 5 Wrought iron 8 Concrete tile CASING JOINTS: Glued  Clamped  
 1 Steel 3 RMP (SR) 6 Asbestos-Cement 9 Other (specify below) Welded  
 PVC 4 ABS 7 Fiberglass Threaded

Blank casing diameter ... 5 ... in. to ... 40 ... ft., Dia ... in. to ... ft., Dia ... in. to ... ft.  
 Casing height above land surface ... 12 ... in., weight ... 2.37 ... lbs./ft. Wall thickness or gauge No. ... 214

TYPE OF SCREEN OR PERFORATION MATERIAL:  PVC 10 Asbestos-cement  
 1 Steel 3 Stainless steel 5 Fiberglass 8 RMP (SR) 11 Other (specify)  
 2 Brass 4 Galvanized steel 6 Concrete tile 9 ABS 12 None used (open hole)

SCREEN OR PERFORATION OPENINGS ARE: 5 Gauzed wrapped 8 Saw cut 11 None (open hole)  
 1 Continuous slot  Mill slot 6 Wire wrapped 9 Drilled holes  
 2 Louvered shutter 4 Key punched 7 Torch cut 10 Other (specify)

SCREEN-PERFORATED INTERVALS: From ... 40 ... ft. to ... 60 ... ft., From ... ft. to ... ft.  
 GRAVEL PACK INTERVALS: From ... 20 ... ft. to ... 60 ... ft., From ... ft. to ... ft.

6 GROUT MATERIAL: 1 Neat cement 2 Cement grout  Bentonite 4 Other  
 Grout Intervals: From ... 0 ... ft. to ... 20 ... ft., From ... ft. to ... ft., From ... ft. to ... ft.

What is the nearest source of possible contamination: 10 Livestock pens 14 Abandoned water well  
 1 Septic tank 4 Lateral lines 7 Pit privy 11 Fuel storage 15 Oil well/Gas well  
 2 Sewer lines 5 Cess pool  Sewage lagoon 12 Fertilizer storage 16 Other (specify below)  
 3 Watertight sewer lines 6 Seepage pit 9 Feedyard 13 Insecticide storage  
 Direction from well? South How many feet? 150

FROM	TO	LITHOLOGIC LOG	FROM	TO	PLUGGING INTERVALS
0	2	Topsoil			
2	6	Tan Clay			
6	25	Gray Shale			
25	30	Sandstone with smallshale layers			
30	60	Sandstone with sandrock layers			
60		Gray Shale			

7 CONTRACTOR'S OR LANDOWNER'S CERTIFICATION: This water well was  constructed, (2) reconstructed, or (3) plugged under my jurisdiction and was completed on (mo/day/year) ... 4/1/97 ... and this record is true to the best of my knowledge and belief. Kansas Water Well Contractor's License No. ... 138 ... This Water Well Record was completed on (mo/day/yr) ... 4/4/97 ... under the business name of Peterson Irrigation, Inc. by (signature) Mike Peterson