


1 LOCATION OF WATER WELL: County: Ottawa		Fraction NW 1/4 NW 1/4 NW 1/4	Section Number 31	Township Number T 11 S	Range Number R 2 E/W
--	--	---	-----------------------------	----------------------------------	--------------------------------

Distance and direction from nearest town or city street address of well if located within city?

1 1/4 N & 1/2 mile E of Bennington, Kansas

2 WATER WELL OWNER: Greg Wolf	Board of Agriculture, Division of Water Resources
RR#, St. Address, Box # : Box 307	Application Number:
City, State, ZIP Code : Bennington, Kansas 67422	

3 LOCATE WELL'S LOCATION WITH AN "X" IN SECTION BOX:

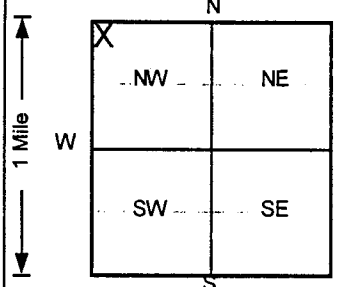

4 DEPTH OF COMPLETED WELL 30 ft ELEVATION:

Depth(s) Groundwater Encountered 1. ft 2. ft 3. ft

WELL'S STATIC WATER LEVEL . . . 999 . . . ft below land surface measured on mo/day/yr

Pump test data: Well water was . . . NA . . . ft after hours pumping gpm

Est. Yield . . NA . . . gpm: Well water was ft after hours pumping gpm

Bore Hole Diameter 8 . . . in. to 30 ft, and in. to ft

WELL WATER TO BE USED AS:

5 Public water supply	8 Air conditioning	11 Injection well
1 Domestic	3 Feedlot	6 Oil field water supply
2 Irrigation	4 Industrial	7 Lawn and garden only
		10 Monitoring well
12 Other (Specify below)		

Was a chemical/bacteriological sample submitted to Department? Yes No ; If yes, mo/day/yr sample was submitted

Water Well Disinfected? Yes No

5 TYPE OF BLANK CASING USED:			5 Wrought iron	8 Concrete tile	CASING JOINTS: Glued Clamped
1 Steel	3 RMP (SR)	6 Asbestos-Cement	9 Other (specify below)		Welded
2 PVC	4 ABS	7 Fiberglass			Threaded. <input checked="" type="checkbox"/>

Blank casing diameter 2 in. to 10 ft, Dia in. to ft, Dia in. to ft

Casing height above land surface 32 in., weight Sch 40 lbs./ft. Wall thickness or gauge No.

TYPE OF SCREEN OR PERFORATION MATERIAL			7 PVC	10 Asbestos-cement
1 Steel	3 Stainless steel	5 Fiberglass	8 RMP (SR)	11 Other (specify)
2 Brass	4 Galvanized steel	6 Concrete tile	9 ABS	12 None used (open hole)

SCREEN OR PERFORATION OPENINGS ARE:			5 Gauzed wrapped	8 Saw cut	11 None (open hole)
1 Continuous slot	3 Mill slot	6 Wire wrapped	9 Drilled holes		
2 Louvered shutter	4 Key punched	7 Torch cut	10 Other (specify)		

SCREEN-PERFORATED INTERVALS: From 10 ft to 30 ft, From ft to ft

From ft to ft, From ft to ft

GRAVEL PACK INTERVALS: From 9 ft to 30 ft, From ft to ft

From ft to ft, From ft to ft

6 GROUT MATERIAL:	1 Neat cement	2 Cement grout	3 Bentonite	4 Other
-------------------	---------------	-----------------------	--------------------	-------------------

Grout Intervals: From 0 ft to 4 ft, From 4 ft to 9 ft, From ft to ft

What is the nearest source of possible contamination:

1 Septic tank	4 Lateral lines	7 Pit privy	10 Livestock pens	14 Abandoned water well
2 Sewer lines	5 Cess pool	8 Sewage lagoon	11 Fuel storage	15 Oil well/Gas well
3 Watertight sewer lines	6 Seepage pit	9 Feedyard	12 Fertilizer storage	16 Other (specify below)
			13 Insecticide storage	

Direction from well? **South**

How many feet? **150**

FROM	TO	LITHOLOGIC LOG	FROM	TO	PLUGGING INTERVALS
------	----	----------------	------	----	--------------------

0	0.5	Dark Topsoil,			
0.5	2	Sand, Brown			
2	3	Clay, Dark Brown			
3	5	Sand, Brown			
5	9	Sand, Orange Brown			
9	15	Sand, Brown			
15	20	Clay, Dark Brown			
20	26	Clay, Yellowish Grey			
26	30	Clay, Yellowish			

MW3, Tag # , Abovegrade

Project Name: **Wolf Feedyard - Bennington**

GeoCore # **656**, #

7 CONTRACTOR'S OR LANDOWNER'S CERTIFICATION: This water well was **(1)** constructed, (2) reconstructed, or (3) plugged under my jurisdiction and was completed on (mo/day/year) **3/25/98** and this record is true to the best of my knowledge and belief.

Kansas Water Well Contractor's License No. **527** This Water Well Record was completed on (mo/day/yr) **4/8/98**

under the business name of **GeoCore Services, Inc.** by (signature) **D. E. Reel**

INSTRUCTIONS: Use typewriter or ball point pen. PLEASE PRESS FIRMLY and PRINT clearly. Please fill in blanks, underline or circle the correct answers. Send top three copies to Kansas Department of Health and Environment, Bureau of Water, Topeka, Kansas 66620-0001. Telephone: 913-296-5545. Send one to WATER WELL OWNER and retain one for your records.

OFFICE USE ONLY

T

R

E/W

SEC.

1/4

1/4

1/4