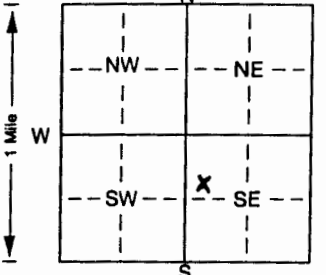


1] LOCATION OF WATER WELL: Fraction SW 1/4 NW 1/4 SE 1/4 Section Number 31 Township Number T 11 S Range Number R 2 E  
 County: Ottawa

Distance and direction from nearest town or city street address of well if located within city:  
1 mile N. 3/4 m E of Bennington Ks, 1871 Frontier Rd, Bennington, Ks.

2] WATER WELL OWNER: Mark Johnson  
 RR#, St. Address, Box #: 1871 Frontier Rd  
 City, State, ZIP Code: Bennington Ks  
 Board of Agriculture, Division of Water Resources  
 Application Number:

3] LOCATE WELL'S LOCATION WITH AN "X" IN SECTION BOX:  
  
 4] DEPTH OF COMPLETED WELL: 49.4 ft. ELEVATION: ..... ft.  
 Depth(s) Groundwater Encountered 1. 2.9 ft. 2. .... ft. 3. .... ft.  
 WELL'S STATIC WATER LEVEL: 2.9 ft. below land surface measured on mo/day/yr 11/26/02  
 Pump test data: Well water was ..... ft. after ..... hours pumping ..... gpm  
 Est. Yield 2.0 gpm: Well water was ..... ft. after ..... hours pumping ..... gpm  
 Bore Hole Diameter: 8 3/4 in. to 51 ft., and ..... in. to ..... ft.  
 WELL WATER TO BE USED AS: 5 Public water supply 8 Air conditioning 11 Injection well  
 1 Domestic 3 Feedlot 6 Oil field water supply 9 Dewatering 12 Other (Specify below)  
 2 Irrigation 4 Industrial 7 Domestic (lawn & garden) 10 Monitoring well  
 Was a chemical/bacteriological sample submitted to Department? Yes. .... No. ; If yes, mo/day/yr sample was submitted  
 Water Well Disinfected? Yes  No

5] TYPE OF BLANK CASING USED:  
 1 Steel 3 RMP (SR) 5 Wrought iron 8 Concrete tile CASING JOINTS: Glued.  Clamped. ....  
2 PVC 4 ABS 6 Asbestos-Cement 9 Other (specify below) Welded .....  
 7 Fiberglass Threaded .....  
 Blank casing diameter 5 in. to 35.4 ft., Dia ..... in. to ..... ft., Dia ..... in. to ..... ft.  
 Casing height above land surface 1.5 in., weight 160 lb lbs./ft. Wall thickness or gauge No. ....  
 TYPE OF SCREEN OR PERFORATION MATERIAL:  
 1 Steel 3 Stainless steel 5 Fiberglass 7 PVC 10 Asbestos-cement  
 2 Brass 4 Galvanized steel 6 Concrete tile 8 RMP (SR) 11 Other (specify) .....  
 9 ABS 12 None used (open hole)  
 SCREEN OR PERFORATION OPENINGS ARE:  
 1 Continuous slot 3 Mill slot 5 Gauzed wrapped 8 Saw cut 11 None (open hole)  
 2 Louvered shutter 4 Key punched 6 Wire wrapped 9 Drilled holes  
 7 Torch cut 10 Other (specify) ..... ft.  
 SCREEN-PERFORATED INTERVALS: From 49.4 ft. to 35.4 ft., From ..... ft. to ..... ft.  
 From ..... ft. to ..... ft., From ..... ft. to ..... ft.  
 GRAVEL PACK INTERVALS: From 51 ft. to 20 ft., From ..... ft. to ..... ft.  
 From ..... ft. to ..... ft., From ..... ft. to ..... ft.

6] GROUT MATERIAL: 1 Neat cement 2 Cement grout 3 Bentonite 4 Other .....  
 Grout Intervals: From 20 ft. to 0 ft., From ..... ft. to ..... ft., From ..... ft. to ..... ft.  
 What is the nearest source of possible contamination:  
 1 Septic tank 4 Lateral lines 7 Pit privy 10 Livestock pens 14 Abandoned water well  
 2 Sewer lines 5 Cess pool 8 Sewage lagoon 11 Fuel storage 15 Oil well/Gas well  
 3 Watertight sewer lines 6 Seepage pit 9 Feedyard 12 Fertilizer storage 16 Other (specify below)  
 13 Insecticide storage .....  
 Direction from well? N How many feet? 75

FROM	TO	LITHOLOGIC LOG	FROM	TO	PLUGGING INTERVALS
0	6	Clay - dk brown, sandy			
6	15	Clay - brown, silty, sandy			
15	34	Clay - brown, v. sandy (v.f.)			
34	40	Sand - m-c			
40	50	Sand and SS gravel			
50	51	Clay - dk gray			
51		Shale			

7] CONTRACTOR'S OR LANDOWNER'S CERTIFICATION: This water well was (1) constructed, (2) reconstructed, or (3) plugged under my jurisdiction and was completed on (mo/day/year) 11/26/02 and this record is true to the best of my knowledge and belief. Kansas Water Well Contractor's Licence No. 527 This Water Well Record was completed on (mo/day/yr) 11/26/02 under the business name of GeoCore, Inc by (signature) Dale Kell