


WATER WELL RECORD Form WWC-5 KSA 82a-1212

1 LOCATION OF WATER WELL: County: <u>OTTAWA</u>	Fraction <u>NW 1/4 NW 1/4 SW 1/4</u>	Section Number <u>9</u>	Township Number <u>T 11 S</u>	Range Number <u>R 2 EW</u>
--	---	----------------------------	----------------------------------	-------------------------------

Distance and direction from nearest town or city street address of well if located within city?  
1/2 MILE NORTH OF INTERSECTION HWY K-106 AND 200th RD. EAST SIDE OTTAWA COUNTY PERMIT# 98-217

2 WATER WELL OWNER: JEFF WOODS  
 RR#, St. Address, Box # : 506 N. STRUBLE ST. Board of Agriculture, Division of Water Resources  
 City, State, ZIP Code : BENNINGTON, KS. 67422 Application Number:

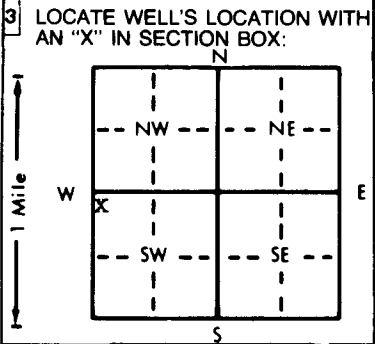

4 DEPTH OF COMPLETED WELL: 79.6 ft. ELEVATION: .....

Depth(s) Groundwater Encountered 1. 50.1 ft. 2. .... ft. 3. .... ft.

WELL'S STATIC WATER LEVEL 50.1 ft. below land surface measured on mo/day/yr 2-24-98

Pump test data: Well water was 53.6 ft. after 1 hours pumping 15 gpm

Est. Yield 50+ gpm: Well water was ..... ft. after ..... hours pumping ..... gpm

Bore Hole Diameter: 9 in. to 80 ft., and ..... in. to ..... ft.

WELL WATER TO BE USED AS:

5 Public water supply	8 Air conditioning	11 Injection well
1 <u>Domestic</u>	3 Feedlot	6 Oil field water supply
2 Irrigation	4 Industrial	7 Lawn and garden only
		10 Monitoring well
		12 Other (Specify below)

Was a chemical/bacteriological sample submitted to Department? Yes..... No X.....; If yes, mo/day/yr sample was submitted

Water Well Disinfected? Yes X No

5 TYPE OF BLANK CASING USED:

1 Steel	3 RMP (SR)	5 Wrought iron	8 Concrete tile	CASING JOINTS: Glued <u>X</u> Clamped .....
2 <u>PVC</u>	4 ABS	6 Asbestos-Cement	9 Other (specify below)	Welded .....
		7 Fiberglass		Threaded .....

Blank casing diameter 5 in. to 63 ft., Dia. .... in. to .... ft., Dia. .... in. to .... ft.

Casing height above land surface 18 in., weight 160 lbs./ft. Wall thickness or gauge No. SDR 26

TYPE OF SCREEN OR PERFORATION MATERIAL:

1 Steel	3 Stainless steel	5 Fiberglass	8 RMP (SR)	11 Other (specify) .....
2 Brass	4 Galvanized steel	6 Concrete tile	9 ABS	12 None used (open hole)

SCREEN OR PERFORATION OPENINGS ARE:

1 Continuous slot	3 Mill slot <u>.035</u>	5 Gauzed wrapped	8 Saw cut	11 None (open hole)
2 Louvered shutter	4 Key punched	6 Wire wrapped	9 Drilled holes	
		7 Torch cut	10 Other (specify) .....	

SCREEN-PERFORATED INTERVALS: From 63 ft. to 79.6 ft., From ..... ft. to ..... ft.

GRAVEL PACK INTERVALS: From 60 ft. to 79.6 ft., From ..... ft. to ..... ft.

6 GROUT MATERIAL: 1 Neat cement 2 Cement grout 3 Bentonite 4 Other .....

Grout Intervals: From 0 ft. to 25 ft., From 57 ft. to 60 ft., From ..... ft. to ..... ft.

What is the nearest source of possible contamination:

1 Septic tank	4 Lateral lines	7 Pit privy	10 Livestock pens	14 Abandoned water well
2 Sewer lines	5 Cess pool	8 Sewage lagoon	11 Fuel storage	15 Oil well/Gas well
3 Watertight sewer lines	6 Seepage pit	9 Feedyard	12 Fertilizer storage	16 Other (specify below)
			13 Insecticide storage	<u>OPEN PASTURE NONE APPARENT</u>

Direction from well? How many feet?

FROM	TO	LITHOLOGIC LOG	FROM	TO	PLUGGING INTERVALS
0	1	TOP SOIL			
<del>15</del>	56	SANDSTONE WITH CLAY LAYERS MIXED			
56	80	SANDSTONE TAN MED. GRAIN			

7 CONTRACTOR'S OR LANDOWNER'S CERTIFICATION: This water well was (1) constructed, (2) reconstructed, or (3) plugged under my jurisdiction and was completed on (mo/day/year) 2-24-98 and this record is true to the best of my knowledge and belief. Kansas Water Well Contractor's License No. 388 This Water Well Record was completed on (mo/day/yr) 2-24-98 under the business name of PESTINGER PUMP SERVICE by (signature) [Signature]

INSTRUCTIONS: Use typewriter or ball point pen. PLEASE PRESS FIRMLY and PRINT clearly. Please fill in blanks, underline or circle the correct answers. Send top three copies to Kansas Department of Health and Environment, Bureau of Water, Topeka, Kansas 66620-0001. Telephone: 913-296-5545. Send one to WATER WELL OWNER and retain one for your records.

OFFICE USE ONLY  
T  
R  
EM  
SEC.  
1/4  
1/4  
1/4