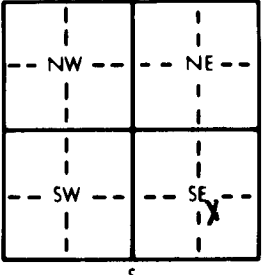


1 LOCATION OF WATER WELL: Fraction **NE SE 1/4 SE 1/4** Section Number **14** Township Number **T 11 S** Range Number **R 20 E**

County: **ELLIS**
 Distance and direction from nearest town or city street address of well if located within city?
1.0 MILES NORTH OF ELLIS 3 EAST

2 WATER WELL OWNER: **WESTERN STAR AG RESOURCES INC**
 RR#, St. Address, Box #: **P.O. BOX 1393**
 City, State, ZIP Code: **SALINA, KANSAS 67402-1393**
 Board of Agriculture, Division of Water Resources
 Application Number:


3 LOCATE WELL'S LOCATION WITH AN "X" IN SECTION BOX:

 4 DEPTH OF COMPLETED WELL: **33.4** ft. ELEVATION:
 Depth(s) Groundwater Encountered: **1. 5 1/2** ft. 2. ft. 3. ft.
 WELL'S STATIC WATER LEVEL: **5 1/2** ft. below land surface measured on **mo/day/yr 2/3/90**
 Pump test data: Well water was ft. after hours pumping gpm
 Est. Yield gpm: Well water was ft. after hours pumping gpm
 Bore Hole Diameter in. to ft. and in. to ft.
 WELL WATER TO BE USED AS:
 1 Domestic 2 Irrigation 3 Feedlot 4 Industrial 5 Public water supply 6 Oil field water supply 7 Lawn and garden only 8 Air conditioning 9 Dewatering 10 Monitoring well 11 Injection well 12 Other (Specify below)
 Was a chemical/bacteriological sample submitted to Department? Yes No; If yes, mo/day/yr sample was submitted
 Water Well Disinfected? Yes No

5 TYPE OF BLANK CASING USED:
 1 Steel 2 PVC 3 RMP (SR) 4 ABS 5 Wrought iron 6 Asbestos-Cement 7 Fiberglass 8 Concrete tile 9 Other (specify below) CASING JOINTS: Glued Clamped Welded Threaded
 Blank casing diameter **16** in. to **33.4** ft. Dia. in. to ft. Dia. in. to ft.
 Casing height above land surface in. weight lbs./ft. Wall thickness or gauge No.
 TYPE OF SCREEN OR PERFORATION MATERIAL:
 X Steel 2 Brass 3 Stainless steel 4 Galvanized steel 5 Fiberglass 6 Concrete tile 7 PVC 8 RMP (SR) 9 ABS 10 Asbestos-cement 11 Other (specify) 12 None used (open hole)
 SCREEN OR PERFORATION OPENINGS ARE:
 1 Continuous slot 2 Louvered shutter 3 Mill slot 4 Key punched 5 Gauzed wrapped 6 Wire wrapped 7 Torch cut 8 Saw cut 9 Drilled holes 10 Other (specify) 11 None (open hole)
 SCREEN-PERFORATED INTERVALS: From ft. to ft. From ft. to ft. From ft. to ft.
 GRAVEL PACK INTERVALS: From ft. to ft. From ft. to ft. From ft. to ft.

6 GROUT MATERIAL: 1 Neat cement 2 Cement grout 3 Bentonite 4 Other
 Grout Intervals: From **15** ft. to **+4** ft. From ft. to ft. From ft. to ft.
 What is the nearest source of possible contamination:
 1 Septic tank 2 Sewer lines 3 Watertight sewer lines 4 Lateral lines 5 Cess pool 6 Seepage pit 7 Pit privy 8 Sewage lagoon 9 Feedyard 10 Livestock pens 11 Fuel storage 12 Fertilizer storage 13 Insecticide storage 14 Abandoned water well 15 Oil well/Gas well 16 Other (specify below)
 Direction from well? **NW** How many feet? **2000**

FROM	TO	LITHOLOGIC LOG	FROM	TO	PLUGGING INTERVALS
			33.4	15	GRAVEL & SAND
			15	14	HOLE PLUG
			14	7	CEMENT GROUT
			7	+4	SAND

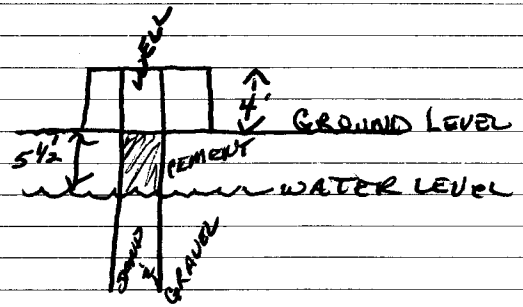16" CASING



7 CONTRACTOR'S OR LANDOWNER'S CERTIFICATION: This water well was (1) constructed, (2) reconstructed, or (3) plugged under my jurisdiction and was completed on (mo/day/year) **3/3/90** and this record is true to the best of my knowledge and belief. Kansas Water Well Contractor's License No. **478** This Water Well Record was completed on (mo/day/yr) **3/3/90** under the business name of **Spanners Water Well Inc.** by signature **Kathy Spanner**