


1 LOCATION OF WATER WELL: Fraction SW 1/4 SE 1/4 SE 1/4 Section Number 35 Township Number T 11 S Range Number R 20 **EW**  
 County: ELLIS

Distance and direction from nearest town or city street address of well if located within city?  
7 NORTH, 3 EAST OF ELLIS KS

2 WATER WELL OWNER: JoAnn Schoenthaler  
 RR#, St. Address, Box #: RR Board of Agriculture, Division of Water Resources  
 City, State, ZIP Code: ELLIS KS 67637 Application Number:

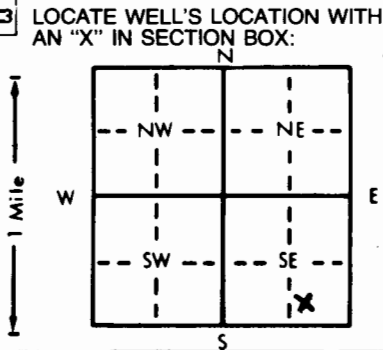

4 DEPTH OF COMPLETED WELL: 46 ft. ELEVATION: ..... ft.  
 Depth(s) Groundwater Encountered 1. 30 ft. 2. .... ft. 3. .... ft.  
 WELL'S STATIC WATER LEVEL: 35 ft. below land surface measured on mo/day/yr 7-13-83  
 Pump test data: Well water was 11 ft. after 1 hours pumping 20 gpm  
 Est. Yield 20 gpm: Well water was ..... ft. after ..... hours pumping ..... gpm  
 Bore Hole Diameter: 10 in. to ..... ft., and ..... in. to ..... ft.  
 WELL WATER TO BE USED AS:  
 1 Domestic     2 Irrigation     3 Feedlot     4 Industrial  
 5 Public water supply     6 Oil field water supply     7 Lawn and garden only  
 8 Air conditioning     9 Dewatering     10 Observation well  
 11 Injection well     12 Other (Specify below)  
 Was a chemical/bacteriological sample submitted to Department? Yes.....No.....; If yes, mo/day/yr sample was submitted  
 Water Well Disinfected?  Yes     No

5 TYPE OF BLANK CASING USED:  
 1 Steel     2 PVC     3 RMP (SR)     4 ABS     5 Wrought iron     6 Asbestos-Cement     7 Fiberglass  
 Blank casing diameter: 5 in. to 26 ft., Dia. .... in. to ..... ft., Dia. .... in. to ..... ft.  
 Casing height above land surface: 20 in., weight ..... lbs./ft. Wall thickness or gauge No. SDR-26  
 TYPE OF SCREEN OR PERFORATION MATERIAL:  
 1 Steel     2 Brass     3 Stainless steel     4 Galvanized steel     5 Fiberglass     6 Concrete tile     7 PVC     8 RMP (SR)     9 ABS     10 Asbestos-cement     11 Other (specify) .....  
 SCREEN OR PERFORATION OPENINGS ARE:  
 1 Continuous slot     2 Louvered shutter     3 Mill slot     4 Key punched     5 Gauzed wrapped     6 Saw cut     7 Wire wrapped     8 Drilled holes     9 Other (specify) .....  
 SCREEN-PERFORATED INTERVALS: From 24 ft. to 46 ft., From ..... ft. to ..... ft.  
 GRAVEL PACK INTERVALS: From 20 ft. to 46 ft., From ..... ft. to ..... ft.

6 GROUT MATERIAL:  1 Neat cement     2 Cement grout     3 Bentonite     4 Other  
 Grout Intervals: From 6 ft. to 16 ft., From ..... ft. to ..... ft.  
 What is the nearest source of possible contamination:  
 1 Septic tank     2 Sewer lines     3 Watertight sewer lines     4 Lateral lines     5 Cess pool     6 Seepage pit     7 Pit privy     8 Sewage lagoon     9 Feedyard     10 Livestock pens     11 Abandoned water well     12 Fuel storage     13 Insecticide storage     14 Oil well/Gas well     15 Fertilizer storage     16 Other (specify below) .....

Direction from well? 5 feet North

FROM	TO	LITHOLOGIC LOG	FROM	TO	LITHOLOGIC LOG
0	10	Top Soil			
10	25	brown clay			
25	45	white rock			
45	46	shale			

7 CONTRACTOR'S OR LANDOWNER'S CERTIFICATION: This water well was  constructed, (2) reconstructed, or (3) plugged under my jurisdiction and was completed on (mo/day/year) 7-13-83 and this record is true to the best of my knowledge and belief. Kansas Water Well Contractor's License No. 276 This Water Well Record was completed on (mo/day/yr) 7/13/83 under the business name of LOEA Water Well by (signature) John Lulea

INSTRUCTIONS: Use typewriter or ball point pen, PLEASE PRESS FIRMLY and PRINT clearly. Please fill in blanks, underline or circle the correct answers. Send top three copies to Kansas Department of Health and Environment, Division of Environment, Environmental Geology Section, Topeka, KS 66620. Send one to WATER WELL OWNER and retain one for your records.

OFFICE USE ONLY  
T 11  
R 20  
EW  
SD 1/4  
SE 1/4