


**1 LOCATION OF WATER WELL:** Fraction  $\frac{1}{4}$  SW  $\frac{1}{4}$  SW  $\frac{1}{4}$  NE  $\frac{1}{4}$  Section Number 24 Township No. T 11 S Range Number R 20  E  W  
 County: Ellis

Street/Rural Address of Well Location; if unknown, distance & direction from nearest town or intersection: If at owner's address, check here   
 Approximately 9 1/2 miles north and 3 1/2 miles east of Ellis.

**Global Positioning System (GPS) information:**  
 Latitude: 39.082051 (in decimal degrees)  
 Longitude: -99.490396 (in decimal degrees)  
 Elevation: unknown  
 Datum:  WGS 84,  NAD 83,  NAD 27  
 Collection Method:  GPS unit (Make/Model: WAAS)  
 Digital Map/Photo,  Topographic Map,  Land Survey  
 Est. Accuracy:  <3 m,  3-5 m,  5-15 m,  >15 m

**2 WATER WELL OWNER:** Western Star Ag Resources  
 RR#, Street Address, Box #: 1244 N. Ohio St  
 City, State, ZIP Code: P.O. Box 1393 Salina, KS 67401

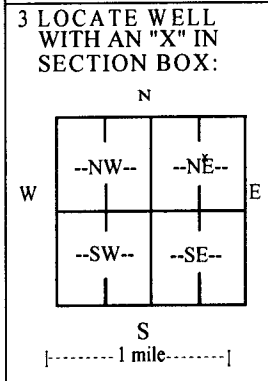

**4 DEPTH OF COMPLETED WELL** 47.10 ft.  
 Depth(s) Groundwater Encountered (1)..... ft. (2)..... ft. (3)..... ft.  
 WELL'S STATIC WATER LEVEL 8.1 ft. below land surface measured on mo/day/yr 03/17/11  
 Pump test data: Well water was not checked ft. after..... hours pumping..... gpm  
 EST. YIELD. unknown gpm. Well water was..... ft. after..... hours pumping..... gpm  
 Bore Hole Diameter 24 in. to 45 ft., and in. to..... ft.  
 WELL WATER TO BE USED AS:  Public water supply  Geothermal  Injection well  
 Domestic  Feedlot  Oil field water supply  Dewatering  Other (Specify below)  
 Irrigation  Industrial  Domestic-lawn & garden  Monitoring well  
 Was a chemical/bacteriological sample submitted to Department?  Yes  No  
 If yes, mo/day/yr sample was submitted.....  
 Water well disinfected?  Yes  No

**5 TYPE OF CASING USED:**  Steel  PVC  Other.....  
 CASING JOINTS:  Glued  Clamped  Welded  Threaded  
 Casing diameter 16 in. to 28 ft., Diameter 16 in. to 45 ft., Diameter..... in. to..... ft.  
 Casing height above land surface 25 in., Weight 19.75 lbs./ft., Wall thickness or gauge No. .616  
 TYPE OF SCREEN OR PERFORATION MATERIAL:  
 Steel  Stainless Steel  PVC  Other (Specify).....  
 Brass  Galvanized Steel  None used (open hole)  
 SCREEN OR PERFORATION OPENINGS ARE:  
 Continuous slot  Mill slot  Gauze wrapped  Torch cut  Drilled holes  None (open hole)  
 Louvered shutter  Key punched  Wire wrapped  Saw cut  Other (specify).....  
 SCREEN-PERFORATED INTERVALS: From 28 ft. to 42 ft., From..... ft. to..... ft.  
 From..... ft. to..... ft., From..... ft. to..... ft.  
 GRAVEL PACK INTERVALS: From 23 ft. to 45 ft., From..... ft. to..... ft.  
 From..... ft. to..... ft., From..... ft. to..... ft.

**6 GROUT MATERIAL:**  Neat cement  Cement grout  Bentonite  Other Compacted Soil  
 Grout Intervals: From..... ft. to..... ft., From 2 ft. to 23 ft., From 0 ft. to 2 ft.  
 What is the nearest source of possible contamination:  
 Septic tank  Lateral lines  Pit privy  Livestock pens  Insecticide storage  Other (specify below)  
 Sewer lines  Cesspool  Sewage lagoon  Fuel storage  Abandoned water well  
 Watertight sewer lines  Seepage pit  Feedyard  Fertilizer storage  Oil well/gas well None known  
 Direction from well..... Distance from well.....

FROM	TO	LITHOLOGIC LOG	FROM	TO	LITHO. LOG (cont.) or PLUGGING INTERVALS
0	1	Topsoil			
1	16	Sand, gravel, fine to coarse			
16	19	Sand, gravel, fine to coarse, with clay, gray			
19	41	Sand, gravel, fine to coarse, clay streak at 29 feet, thin			
41	45	Shale, black			

**7 CONTRACTOR'S OR LANDOWNER'S CERTIFICATION:** This water well was  constructed,  reconstructed, or  plugged under my jurisdiction and was completed on (mo/day/year) 3/17/11 and this record is true to the best of my knowledge and belief.  
 Kansas Water Well Contractor's License No. 185 This Water Well Record was completed on (mo/day/year) 3/22/11  
 under the business name of Clarke Well & Equipment, Inc. by (signature) [Signature]

INSTRUCTIONS: Use typewriter or ball point pen. PLEASE PRESS FIRMLY and PRINT clearly. Please fill in blanks and check the correct answers. Send three copies (white, blue, pink) to Kansas Department of Health and Environment, Bureau of Water, Geology Section, 1000 SW Jackson St., Suite 420, Topeka, Kansas 66612-1367. Telephone 785-296-5522. Send one copy to WATER WELL OWNER and retain one for your records. Include fee of \$5.00 for each constructed well. Visit us at <http://www.kdheks.gov/waterwell/index.html>.