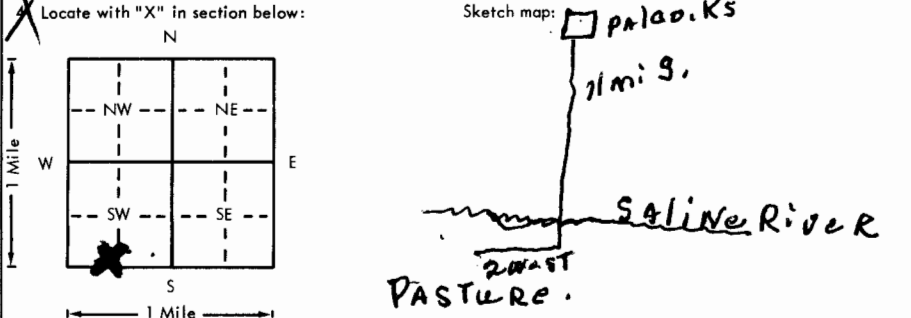


USE TYPEWRITER OR BALL  
POINT PEN-PRESS FIRMLY,  
PRINT CLEARLY.

WATER WELL RECORD  
KSA 82a-1201-1215

Kansas Department of Health and  
Environment-Division of Environment  
(Water well Contractors)  
Topeka, Kansas 66620

1. Location of well:		County <b>Trego</b>	X Action <b>SE 1/4 SE 1/4 SW 1/4</b>	Section number <b>11</b>	Township number <b>T 11 S</b>	Range number <b>R 21 E</b>
2. Distance and direction from nearest town or city: <b>South 2 miles west of PAICO, KANS.</b>			3. Owner of well: <b>HENRY WALZ</b> R.R. or street: <b>ELLIS, KANS. 67637</b> City, state, zip code:			
X Locate with "X" in section below:		Sketch map: 			6. Bore hole dia. <b>9"</b> in. Completion date Well depth <b>19</b> ft. <b>8/5/78</b>	
5. Type and color of material		From	To	7. Cable tool <input checked="" type="checkbox"/> Rotary <input type="checkbox"/> Driven <input type="checkbox"/> Dug <input type="checkbox"/> Hollow rod <input type="checkbox"/> Jetted <input type="checkbox"/> Bored <input type="checkbox"/> Reverse rotary		
Clay		0	3	8. Use: <input type="checkbox"/> Domestic <input type="checkbox"/> Public supply <input type="checkbox"/> Industry <input type="checkbox"/> Irrigation <input type="checkbox"/> Air conditioning <input checked="" type="checkbox"/> Stock <input type="checkbox"/> Lawn <input type="checkbox"/> Oil field water <input type="checkbox"/> Other		
Sand		3	13	9. Casing: Material <b>PLASTIC</b> Height: Above or below Threading <b>9"</b> Welded <input type="checkbox"/> Surface <b>48</b> in. RMP <input type="checkbox"/> PVC <input checked="" type="checkbox"/> Weight <input type="checkbox"/> lbs./ft. Dia. <b>5</b> in. to <b>19</b> ft. depth Wall Thickness: inches or Dia. <input type="checkbox"/> in. to <input type="checkbox"/> ft. depth gage No. <b>250</b>		
Shale		13	19	10. Screen: Manufacturer's name <b>CRAW</b> <b>LINE PLASTIC INC.</b> Type <b>PLASTIC</b> Dia. <b>5"</b> Slot/gauze <b>1/16</b> Length <b>10</b> Set between <b>0</b> ft. and <b>10</b> ft. ft. and <input type="checkbox"/> ft. Gravel pack? <b>YES</b> Size range of material <b>1/4-9/16</b>		
BRICK 13				11. Static water level: <input type="checkbox"/> mo./day/yr. <b>5</b> ft. below land surface Date <b>8/5/78</b>		
13				12. Pumping level below land surfaces: <b>NOT PUMPED</b> ft. after <input type="checkbox"/> hrs. pumping <input type="checkbox"/> g.p.m. ft. after <input type="checkbox"/> hrs. pumping <input type="checkbox"/> g.p.m. Estimated maximum yield <input type="checkbox"/> g.p.m.		
5' possibly in Og (1 mi south of contact on work map) - more likely in alluvium from Saline River				13. Water sample submitted: <input type="checkbox"/> mo./day/yr. <input checked="" type="checkbox"/> Yes <input checked="" type="checkbox"/> No Date <input type="checkbox"/>		
2178				14. Well head completion: <b>NOT DONE</b> <input type="checkbox"/> Pitless adapter <input type="checkbox"/> Inches above grade		
2165				15. Well grouted? <b>YES</b> With: <input checked="" type="checkbox"/> Neat cement <input type="checkbox"/> Bentonite <input type="checkbox"/> Concrete Depth: From <b>0</b> ft. to <b>10</b> ft.		
2178				16. Nearest source of possible contamination: <b>SALINE</b> ft. <b>560</b> Direction <b>NORTH</b> Type <b>RIVER</b> Well disinfected upon completion? <input checked="" type="checkbox"/> Yes <input type="checkbox"/> No		
(Use a second sheet if needed)				17. Pump: <input checked="" type="checkbox"/> Not installed Manufacturer's name <input type="checkbox"/> Model number <input type="checkbox"/> HP <input type="checkbox"/> Volts <input type="checkbox"/> Length of drop pipe <input type="checkbox"/> ft. capacity <input type="checkbox"/> g.p.m. Type: <input type="checkbox"/> Submersible <input type="checkbox"/> Turbine <input type="checkbox"/> Jet <input type="checkbox"/> Reciprocating <input type="checkbox"/> Centrifugal <input type="checkbox"/> Other		
18. Elevation:		19. Remarks:		20. Water well contractor's certification: This well was drilled under my jurisdiction and this report is true to the best of my knowledge and belief. <b>D. E. L. DRILLING CO. 303</b> Business name <b>Box 868 Hill City, KS. 67642</b> License No. Address <b>Allen L. Thomas</b> Date <b>8/7/78</b> Signed <b>Allen L. Thomas</b> Authorized representative		
Topography: <input type="checkbox"/> Hill <input type="checkbox"/> Slope <input type="checkbox"/> Upland <input checked="" type="checkbox"/> Valley		CONCRETE slab to be INSTALLED by customer.				

Forward the white, blue and pink copies to the Department of Health and Environment

Form WWC-5