USE TYPEWRITER OR BALL POINT PEN-PRESS FIRMLY, PRINT CLEARLY.

WATER WELL RECORD
KSA 82a-1201-1215

Kansas Department of Health and Environment-Division of Environment
(Water well Contractors)
Topeka, Kansas 66620

DBB

1. Location of well:	County	Fraction	Section number	Township number	Range number
	Trego	NW 1/4 NW 1/4 SE 1/4	16	T 11 S	R 22 E/W

2. Distance and direction from nearest town or city: 8 North & 1 mile west of
Street address of well location if in city: Ogallah, Ks.

3. Owner of well: Kenneth Wolf
R.R. or street: R.F.D. #2
City, state, zip code: Ellis, Ks. 67637

4. Locate with "X" in section below:

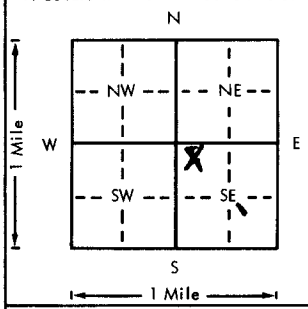

Sketch map:

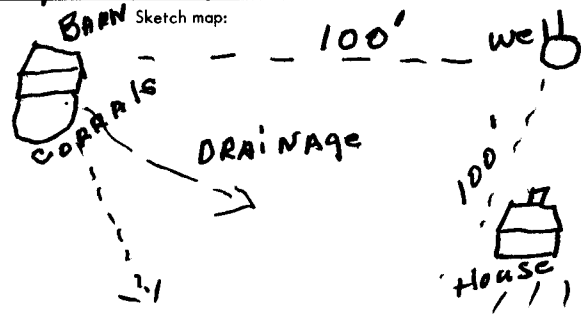

6. Bore hole dia. 9 in. Completion date 5/24/79
Well depth 72 ft.

7. __ Cable tool X Rotary __ Driven __ Dug
__ Hollow rod __ Jetted __ Bored __ Reverse rotary

8. Use: X Domestic __ Public supply __ Industry
__ Irrigation __ Air conditioning __ Stock
__ Lawn __ Oil field water __ Other

9. Casing: Material plastic Height: Above or below
Threaded ___ Welded glued surface 18 in.
RMP X PVC ___ Weight ___ lbs./ft.
Dia. 5 in. to 72 ft. depth Wall Thickness: inches or
Dia. ___ in. to ___ ft. depth gage No. .250

5. Type and color of material	From	To
Clay	0	14
Sand	14	30
Mud	30	55
Sand	55	72
Shale at	72	-
BRUCK 72'		
72 / 24 / 48 sat th	2180 / 72 / 2108	
48' sat thick - possible Oil (- N		
1 mile from contact on work map) -		
probably in alluvium of Saline River		
(Use a second sheet if needed)		

10. Screen: Manufacturer's name Superior
Type plastic Dia. 5"
Slot/gauze 1/16 Length 10'
Set between 62 ft. and 72 ft.
___ ft. and ___ ft.
Gravel pack? yes Size range of material 1/4 - 5/8

11. Static water level: mo./day/yr.
24 ft. below land surface Date 5/24/79

12. Pumping level below land surfaces: Not done
___ ft. after ___ hrs. pumping ___ g.p.m.
___ ft. after ___ hrs. pumping ___ g.p.m.
Estimated maximum yield ___ g.p.m.

13. Water sample submitted: mo./day/yr.
__ Yes X No Date ___

14. Well head completion: No.
__ Pitless adapter ___ Inches above grade

15. Well grouted? yes
With: X Neat cement ___ Bentonite ___ Concrete
Depth: From 0 ft. to 10 ft.

16. Nearest source of possible contamination: CORRALS
ft. 100 Direction West Type BARN
Well disinfected upon completion? X Yes ___ No

17. Pump: X Not installed
Manufacturer's name ___
Model number ___ HP ___ Volts ___
Length of drop pipe ___ ft. capacity ___ g.p.m.
Type:
__ Submersible __ Turbine
__ Jet __ Reciprocating
__ Centrifugal __ Other

18. Elevation:

Topography:
__ Hill
__ Slope
__ Upland
X Valley

19. Remarks:
Concrete slab to be installed by customer at ground level.
2180 TOPO

20. Water well contractor's certification:
This well was drilled under my jurisdiction and this report is true to the best of my knowledge and belief.
D & L Drilling Co 303
Business name License No.
Address Box 368 Hill City, Ks.
Signed [signature] Date 7-16-79
Authorized representative

T 11 R 22 E/W Sec 16 1/4 NW 1/4 NW 1/4 SE 1/4

Forward the white, blue and pink copies to the Department of Health and Environment

Form WWC-5

MI-1023