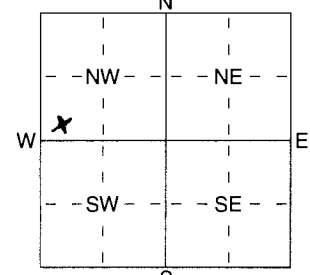


1 LOCATION OF WATER WELL: Fraction SW 1/4 SW 1/4 NW 1/4 Section Number 20 Township Number T 11 S Range Number R 23 E  
 County: Trigo

Distance and direction from nearest town or city street address of well if located within city?  
1 1/2 S 2 W of Wakarusa Ks

2 WATER WELL OWNER: Maia Pence  
 RR#, St. Address, Box # : Wakarusa Ks Board of Agriculture, Division of Water Resources  
 City, State, ZIP Code : Application Number:

3 LOCATE WELL'S LOCATION WITH AN "X" IN SECTION BOX:  
  
 4 DEPTH OF COMPLETED WELL 120 ft. ELEVATION: ..... ft.  
 Depth(s) Groundwater Encountered 1 70 ft. 2 ..... ft. 3 ..... ft.  
 WELL'S STATIC WATER LEVEL 70 ft. below land surface measured on mo/day/yr .....  
 Pump test data: Well water was ..... ft. after ..... hours pumping ..... gpm  
 Est. Yield 20 gpm: Well water was ..... ft. after ..... hours pumping ..... gpm  
 WELL WATER TO BE USED AS:  
 1 Domestic    3 Feedlot    6 Oil field water supply    9 Dewatering    12 Other (Specify below)  
 2 Irrigation    4 Industrial    7 Domestic (lawn & garden)    10 Monitoring well  
 Was a chemical/bacteriological sample submitted to Department? Yes ..... No X; If yes, mo/day/yr sample was submitted  
 Water Well Disinfected  Yes    No

5 TYPE OF BLANK CASING USED:  
 1 Steel    3 RMP (SR)    5 Wrought iron    8 Concrete tile    CASING JOINTS: Glued X Clamped .....  
 2 PVC    4 ABS    6 Asbestos-Cement    9 Other (specify below)    Welded .....  
 Blank casing diameter 5 in. to 100 ft., Dia ..... in. to ..... ft., Dia ..... in. to ..... ft.  
 Casing height above land surface 12 in., weight 2.50 lbs./ft. Wall thickness or gauge No. 2.50  
 TYPE OF SCREEN OR PERFORATION MATERIAL:  
 1 Steel    3 Stainless Steel    5 Fiberglass    8 RMP (SR)    10 Asbestos-Cement  
 2 Brass    4 Galvanized Steel    6 Concrete tile    9 ABS    11 Other (Specify) .....  
 12 None used (open hole)  
 SCREEN OR PERFORATION OPENINGS ARE:  
 1 Continuous slot    3 Mill slot    5 Gauzed wrapped    8 Saw cut    11 None (open hole)  
 2 Louvered shutter    4 Key punched    6 Wire wrapped    9 Drilled holes  
 7 Torch cut    10 Other (specify) ..... ft.  
 SCREEN-PERFORATED INTERVALS: From 100 ft. to 120 ft., From ..... ft. to ..... ft.  
 GRAVEL PACK INTERVALS: From 70 ft. to 120 ft., From ..... ft. to ..... ft.

6 GROUT MATERIAL: 1 Neat cement    2 Cement grout     3 Bentonite    4 Other .....  
 Grout Intervals: From 4 ft. to 24 ft., From ..... ft. to ..... ft., From ..... ft. to ..... ft.  
 What is the nearest source of possible contamination:  
 1 Septic tank    4 Lateral lines    7 Pit privy    10 Livestock pens    14 Abandoned water well  
 2 Sewer lines    5 Cess pool    8 Sewage lagoon    11 Fuel storage    15 Oil well/Gas well  
 3 Watertight sewer lines    6 Seepage pit    9 Feedyard    12 Fertilizer storage    16 Other (specify below)  
 Direction from well? South    How many feet? 100

FROM	TO	LITHOLOGIC LOG	FROM	TO	PLUGGING INTERVALS
0	14	Top soil			
14	43	S Clay			
43	48	Gravel			
48	80	Clay			
80	119	Fossiliferous sandstone			
119	120	S. shale			

7 CONTRACTOR'S OR LANDOWNER'S CERTIFICATION: This water well was  (1) constructed, (2) reconstructed, or (3) plugged under my jurisdiction and was completed on (mo/day/year) 12-12 and this record is true to the best of my knowledge and belief. Kansas Water Well Contractor's Licence No 376 This Water Well Record was completed on (mo/day/yr) 12-12 under the business name of B+B Drilling LLC by (signature) Joseph Beckman