


1 LOCATION OF WATER WELL: County: Trego	Fraction NW 1/4 NE 1/4	Section Number 26	Township Number T 11 S	Range Number R 24 EW
--	---------------------------	----------------------	---------------------------	-------------------------

Distance and direction from nearest town or city street address of well if located within city?
Approximately 3 miles north and 4 miles west of WaKeeney

2 WATER WELL OWNER: Kansas Geological Survey
 RR#, St. Address, Box #: 1930 Constant Ave. Board of Agriculture, Division of Water Resources
 City, State, ZIP Code: Lawrence, KS 66045 Application Number:

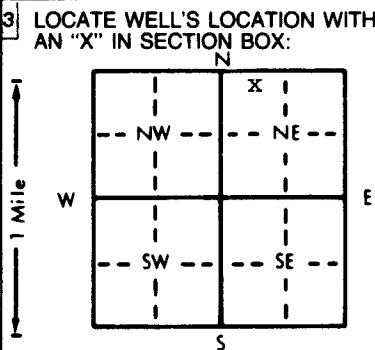

4 DEPTH OF COMPLETED WELL: 971 ft. ELEVATION: unknown

Depth(s) Groundwater Encountered 1. ft. 2. ft. 3. ft.

WELL'S STATIC WATER LEVEL 430.1 ft. below land surface measured on mo/day/yr 5-15-94

Pump test data: Well water was not ch'd ft. after hours pumping gpm

Est. Yield unknown gpm: Well water was ft. after hours pumping gpm

Bore Hole Diameter 14 3/4 in. to 987 ft., and in. to ft.

WELL WATER TO BE USED AS:

5 Public water supply	8 Air conditioning	11 Injection well
1 Domestic	3 Feedlot	6 Oil field water supply
2 Irrigation	4 Industrial	7 Lawn and garden only
		10 Monitoring well
		12 Other (Specify below)
		Observation

Was a chemical/bacteriological sample submitted to Department? Yes No If yes, mo/day/yr sample was submitted

Water Well Disinfected? Yes No

5 TYPE OF BLANK CASING USED:

1 Steel	3 RMP (SR)	5 Wrought iron	8 Concrete tile	CASING JOINTS: Glued Clamped
2 PVC	4 ABS	6 Asbestos-Cement	9 Other (specify below)	Welded <input checked="" type="checkbox"/>
		7 Fiberglass		Threaded

Blank casing diameter 10 3/4 in. to 68 ft., Dia 5 1/2 in. to 952 ft., Dia 5 1/2 in. to 969 ft.

Casing height above land surface 24 in., weight 10 3/4"-24.60, 5 1/2"-14.02 lbs./ft. Wall thickness or gauge No. 5 1/2" 250

TYPE OF SCREEN OR PERFORATION MATERIAL:

1 Steel	3 Stainless steel	5 Fiberglass	8 RMP (SR)	10 Asbestos-cement
2 Brass	4 Galvanized steel	6 Concrete tile	9 ABS	11 Other (specify)
				12 None used (open hole)

SCREEN OR PERFORATION OPENINGS ARE:

1 Continuous slot	3 Mill slot	5 Gauzed wrapped	8 Saw cut	11 None (open hole)
2 Louvered shutter	4 Key punched	6 Wire wrapped	9 Drilled holes	
		7 Torch cut	10 Other (specify)	

SCREEN-PERFORATED INTERVALS: From 952 ft. to 967 ft., From ft. to ft.

GRAVEL PACK INTERVALS: From 911 ft. to 967 ft., From ft. to ft.

6 GROUT MATERIAL: 1 Neat cement 2 Cement grout 3 Bentonite 4 Other

Grout intervals: From 0 ft. to 911 ft., From ft. to ft., From ft. to ft.

What is the nearest source of possible contamination:

1 Septic tank	4 Lateral lines	7 Pit privy	10 Livestock pens	14 Abandoned water well
2 Sewer lines	5 Cess pool	8 Sewage lagoon	11 Fuel storage	15 Oil well/Gas well
3 Watertight sewer lines	6 Seepage pit	9 Feedyard	12 Fertilizer storage	16 Other (specify below)
			13 Insecticide storage	None known

Direction from well? How many feet?

FROM	TO	LITHOLOGIC LOG	FROM	TO	PLUGGING INTERVALS
0	8	Topsoil	902	921	Shale, red
8	16	Clay, brown	921	930	Clay, red to gray
16	23	Limestone	930	950	Shale, red, gray
23	44	Clay, tan to gray with limestone	950	983	Sandstone
		gravel	983	987	Shale, black
44	51	Clay, reddish			
51	57	Clay, gray			
57	65	Shale, gray			
65	202	Shale, gray to black			
202	365	Shale, brownish-black			
365	435	Clay, light gray			
435	875	Shale, gray, dark gray			
875	893	Sandstone, gray			
893	897	Shale, gray			
897	902	Sandstone, gray			

7 CONTRACTOR'S OR LANDOWNER'S CERTIFICATION: This water well was (1) constructed, (2) reconstructed, or (3) plugged under my jurisdiction and was completed on (mo/day/year) 5-15-94 and this record is true to the best of my knowledge and belief. Kansas Water Well Contractor's License No. 185. This Water Well Record was completed on (mo/day/yr) 6-14-94 under the business name of Clarke Well & Equipment, Inc. by (signature) *Clarke Well & Equipment*

OFFICE USE ONLY