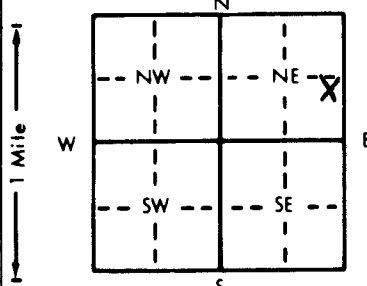


mw-7

1 LOCATION OF WATER WELL: Fraction NE 1/4 SE 1/4 NE 1/4 Section Number 31 Township Number T 11 S Range Number R 26 E/W
 County: Gove

Distance and direction from nearest town or city street address of well if located within city?
E side of Castle Rock Road across from C-Mart #2506

2 WATER WELL OWNER: RR#, St. Address, Box # City of Quinter Attn: Eddue Balluch Board of Agriculture, Division of Water Resources
 City, State, ZIP Code 411 Main, Quinter, Ks 67752 Application Number: _____

3 LOCATE WELL'S LOCATION WITH AN "X" IN SECTION BOX:


4 DEPTH OF COMPLETED WELL: 82 ft. ELEVATION: _____
 Depth(s) Groundwater Encountered 1. 69 ft. 2. _____ ft. 3. _____ ft.
 WELL'S STATIC WATER LEVEL 66.97 ft. below land surface measured on mo/day/yr 9/13/95
 Pump test data: Well water was _____ ft. after _____ hours pumping _____ gpm
 Est. Yield _____ gpm: Well water was _____ ft. after _____ hours pumping _____ gpm
 Bore Hole Diameter 8.625 in. to 8.5 in. and _____ in. to _____ in. ft.
 WELL WATER TO BE USED AS: 5 Public water supply 8 Air conditioning 11 Injection well
 1 Domestic 3 Feedlot 6 Oil field water supply 9 Dewatering 12 Other (Specify below)
 2 Irrigation 4 Industrial 7 Lawn and garden only 10 Monitoring well *mw-7*
 Was a chemical/bacteriological sample submitted to Department? Yes _____ No X If yes, mo/day/yr sample was submitted _____
 Water Well Disinfected? Yes _____ No X

5 TYPE OF BLANK CASING USED: 5 Wrought iron 8 Concrete tile CASING JOINTS: Glued _____ Clamped _____
 1 Steel 3 RMP (SR) 6 Asbestos-Cement 9 Other (specify below) Welded _____
2 PVC 4 ABS 7 Fiberglass _____ Threaded X
 Blank casing diameter 2 in. to 5.7 ft. Dia _____ in. to _____ ft. Dia _____ in. to _____ ft.
 Casing height above land surface 0 in., weight SCH 40 PVC lbs./ft. Wall thickness or gauge No. _____
 TYPE OF SCREEN OR PERFORATION MATERIAL: 7 PVC 10 Asbestos-cement
 1 Steel 3 Stainless steel 5 Fiberglass 8 RMP (SR) 11 Other (specify) _____
 2 Brass 4 Galvanized steel 6 Concrete tile 9 ABS 12 None used (open hole)
 SCREEN OR PERFORATION OPENINGS ARE: 5 Gauzed wrapped 8 Saw cut 11 None (open hole)
 1 Continuous slot 3 Mill slot 6 Wire wrapped 9 Drilled holes
 2 Louvered shutter 4 Key punched 7 Torch cut 10 Other (specify) _____
 SCREEN-PERFORATED INTERVALS: From 5.7 ft. to 8.2 ft., From _____ ft. to _____ ft.
 From _____ ft. to _____ ft., From _____ ft. to _____ ft.
SAND GRAVEL PACK INTERVALS: From 5.6 ft. to 8.5 ft., From _____ ft. to _____ ft.
 From _____ ft. to _____ ft., From _____ ft. to _____ ft.

6 GROUT MATERIAL: 1 Neat cement 2 0 Cement grout 3 0 Bentonite 4 Other _____
 Grout Intervals: From 0 ft. to 5.4 ft., From 5.4 ft. to 5.6 ft., From _____ ft. to _____ ft.
 What is the nearest source of possible contamination: 10 Livestock pens 14 Abandoned water well
 1 Septic tank 4 Lateral lines 7 Pit privy 11 Fuel storage 15 Oil well/Gas well
 2 Sewer lines 5 Cess pool 8 Sewage lagoon 12 Fertilizer storage 16 Other (specify below)
 3 Watertight sewer lines 6 Seepage pit 9 Feedyard 13 Insecticide storage
Contaminated Si
 Direction from well? _____ How many feet? _____

FROM	TO	LITHOLOGIC LOG	FROM	TO	PLUGGING INTERVALS
GL	1.50	Soil			
1.50	27.00	Clayey Silt (ML)			
27.00	48.00	Silty Sand (SM)			
48.00	69.00	Sandy Silt (ML)			
69.00	85.00	Sand (SP), trace silt, tan to brown			
85.00	TD	End of borehole			
					Flush Mount waiver D. Taylor

7 CONTRACTOR'S OR LANDOWNER'S CERTIFICATION: This water well was (1) constructed, (2) reconstructed, or (3) plugged under my jurisdiction and was completed on (mo/day/year) _____ and this record is true to the best of my knowledge and belief. Kansas
 Water Well Contractor's License No. 4/11/96 This Water Well Record was completed on (mo/day/yr) _____
 under the business name of 585 by (signature) D. Johnson *for Dawn Duncan* 4/17/96

OFFICE USE ONLY
T
R
EW
SEC.
1/4
1/4
1/4