


1 LOCATION OF WATER WELL: County: Gove	Fraction NW ¼ NW ¼ NW ¼	Section Number 32	Township Number T 11 S	Range Number R 26 E/W
--	-----------------------------------	-----------------------------	----------------------------------	---------------------------------

Distance and direction from nearest town or city street address of well if located within city?
I-70 and K-212 - Quinter, KS

2 WATER WELL OWNER: **Jim Graham**
RR#, St. Address, Box # : **P.O. Box 398**
City, State, ZIP Code : **Quinter, Kansas 67752**
Board of Agriculture, Division of Water Resources
Application Number:

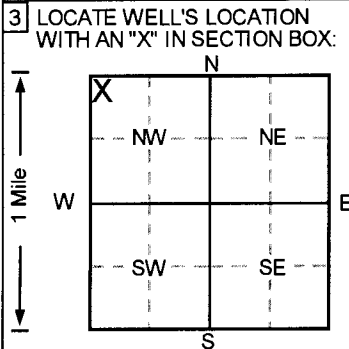

4 DEPTH OF COMPLETED WELL **95** ft. ELEVATION: **2660.06**
Depth(s) Groundwater Encountered 1. **81** ft. 2. ft. 3. ft.
WELL'S STATIC WATER LEVEL **.999** ft. below land surface measured on mo/day/yr
Pump test data: Well water was **NA** ft. after hours pumping gpm
Est. Yield **NA** gpm: Well water was ft. after hours pumping gpm
Bore Hole Diameter **8** in. to **95** ft., and in. to ft.
WELL WATER TO BE USED AS:
5 Public water supply 8 Air conditioning 11 Injection well
1 Domestic 3 Feedlot 6 Oil field water supply 9 Dewatering **12 Other (Specify below)**
2 Irrigation 4 Industrial 7 Lawn and garden only 10 Monitoring well
Air Sparging Well
Was a chemical/bacteriological sample submitted to Department? Yes.....No; If yes, mo/day/yr sample was submitted
Water Well Disinfected? Yes No

5 TYPE OF BLANK CASING USED:
1 Steel 3 RMP (SR) 5 Wrought iron 8 Concrete tile CASING JOINTS: Glued Clamped
2 PVC 4 ABS 6 Asbestos-Cement 9 Other (specify below) Welded
7 Fiberglass Threaded
Blank casing diameter **2** in. to **93** ft., Dia in. to ft., Dia in. to ft.
Casing height above land surface **-5.76** in., weight lbs./ft. Wall thickness or gauge No. **Sch. 40**
TYPE OF SCREEN OR PERFORATION MATERIAL **7 PVC** 10 Asbestos-cement
1 Steel 3 Stainless steel 5 Fiberglass 8 RMP (SR) 11 Other (specify)
2 Brass 4 Galvanized steel 6 Concrete tile 9 ABS 12 None used (open hole)
SCREEN OR PERFORATION OPENINGS ARE:
1 Continuous slot **3 Mill slot** 5 Gauzed wrapped 8 Saw cut 11 None (open hole)
2 Louvered shutter 4 Key punched 6 Wire wrapped 9 Drilled holes
7 Torch cut 10 Other (specify)
SCREEN-PERFORATED INTERVALS: From **93** ft. to **95** ft., From ft. to ft.
From ft. to ft., From ft. to ft.
GRAVEL PACK INTERVALS: From **92** ft. to **95** ft., From ft. to ft.
From ft. to ft., From ft. to ft.

6 GROUT MATERIAL: 1 Neat cement **2 Cement grout** **3 Bentonite** 4 Other
Grout Intervals: From **0** ft. to **80** ft., From **80** ft. to **92** ft., From ft. to ft.
What is the nearest source of possible contamination:
1 Septic tank 4 Lateral lines 7 Pit privy 10 Livestock pens 14 Abandoned water well
2 Sewer lines 5 Cess pool 8 Sewage lagoon 11 Fuel storage 15 Oil well/Gas well
3 Watertight sewer lines 6 Seepage pit 9 Feedyard 12 Fertilizer storage **16 Other (specify below)**
UST Basin
Direction from well? **SE** 13 Insecticide storage How many feet? **97**

FROM	TO	LITHOLOGIC LOG	FROM	TO	PLUGGING INTERVALS
0	0.5	Asphalt,			
0.5	3	Clay, Dark Brown to Brown			
3	12	Clay, Light Brown			
12	22	Clay, Brown			
22	28	Clay, Red Brown			
28	34	Sand, Red Brown			
34	36	Clay, Red Brown			
36	41	Sand, White to Tan			
41	52	Sand, Light Red Brown			
52	80	Sand, Brown to Red Brown			
80	95	Sand, Gray			
					ASP2, Tag # 00175058, Flushmount
					Project Name: Graham 66 Service
					GeoCore # 288, KDHE # U6 032 513

7 CONTRACTOR'S OR LANDOWNER'S CERTIFICATION: This water well was **(1)** constructed, (2) reconstructed, or (3) plugged under my jurisdiction and was completed on (mo/day/year) **1/6/97** and this record is true to the best of my knowledge and belief.
Kansas Water Well Contractor's License No. **527** This Water Well Record was completed on (mo/day/yr) **2/4/97**
under the business name of **GeoCore Services, Inc.** by (signature) *Dale G. Roll*

OFFICE USE ONLY
T
R
E/W
SEC.