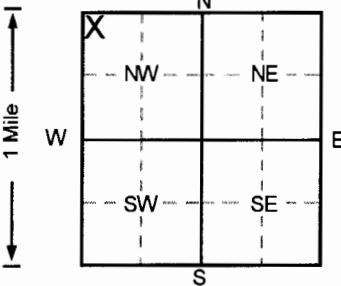


1 LOCATION OF WATER WELL: County: Gove	Fraction NW ¼ NW ¼ NW ¼	Section Number 32	Township Number T 11 S	Range Number R 26 E/W
--	-----------------------------------	-----------------------------	----------------------------------	---------------------------------

Distance and direction from nearest town or city street address of well if located within city?

I-70 and Hwy K212 - Quinter, Kansas

2 WATER WELL OWNER: **Jim Graham**
 RR#, St. Address, Box # : **P.O. Box 398**
 City, State, ZIP Code : **Quinter, Kansas 67752**
 Board of Agriculture, Division of Water Resources
 Application Number:

3 LOCATE WELL'S LOCATION WITH AN "X" IN SECTION BOX: 	4 DEPTH OF COMPLETED WELL 75 ft. ELEVATION: 2659.98
	Depth(s) Groundwater Encountered 1. 999 ft. 2. ft. 3. ft. WELL'S STATIC WATER LEVEL . . . 999 ft. below land surface measured on mo/day/yr Pump test data: Well water was . . . NA ft. after hours pumping gpm Est. Yield . . NA gpm: Well water was ft. after hours pumping gpm Bore Hole Diameter 8 in. to 75 ft., and in. to ft. WELL WATER TO BE USED AS: 5 Public water supply 8 Air conditioning 11 Injection well 1 Domestic 3 Feedlot 6 Oil field water supply 9 Dewatering 12 Other (Specify below) 2 Irrigation 4 Industrial 7 Lawn and garden only 10 Monitoring well Soil Vapor Extracti Was a chemical/bacteriological sample submitted to Department? Yes.....No <input checked="" type="checkbox"/>; If yes, mo/day/yr sample was submitted Water Well Disinfected? Yes No <input checked="" type="checkbox"/>

5 TYPE OF BLANK CASING USED:	5 Wrought iron	8 Concrete tile	CASING JOINTS: Glued Clamped
1 Steel	3 RMP (SR)	6 Asbestos-Cement	9 Other (specify below)
2 PVC	4 ABS	7 Fiberglass	Welded
Blank casing diameter 2 in. to 70 ft., Dia in. to ft., Dia in. to ft.			Threaded. <input checked="" type="checkbox"/>
Casing height above land surface -6.6 in., weight lbs./ft. Wall thickness or gauge No. Sch. 40			
TYPE OF SCREEN OR PERFORATION MATERIAL	7 PVC	10 Asbestos-cement	
1 Steel	3 Stainless steel	5 Fiberglass	8 RMP (SR)
2 Brass	4 Galvanized steel	6 Concrete tile	9 ABS
SCREEN OR PERFORATION OPENINGS ARE:	5 Gauzed wrapped	8 Saw cut	11 None (open hole)
1 Continuous slot	3 Mill slot	6 Wire wrapped	9 Drilled holes
2 Louvered shutter	4 Key punched	7 Torch cut	10 Other (specify)
SCREEN-PERFORATED INTERVALS: From 70 ft. to 75 ft., From ft. to ft.			
GRAVEL PACK INTERVALS: From 69 ft. to 75 ft., From ft. to ft.			

6 GROUT MATERIAL: 1 Neat cement **2 Cement grout** **3 Bentonite** 4 Other
 Grout Intervals: From **0** ft. to **65** ft., From **65** ft. to **69** ft., From ft. to ft.
 What is the nearest source of possible contamination:
 1 Septic tank 4 Lateral lines 7 Pit privy 10 Livestock pens 14 Abandoned water well
 2 Sewer lines 5 Cess pool 8 Sewage lagoon 11 Fuel storage 15 Oil well/Gas well
 3 Watertight sewer lines 6 Seepage pit 9 Feedyard 12 Fertilizer storage **16 Other (specify below)**
 Direction from well? **SE** 13 Insecticide storage **UST Basin**
 How many feet? **105**

FROM	TO	LITHOLOGIC LOG	FROM	TO	PLUGGING INTERVALS
0	0.5	Asphalt,			
0.5	4	Clay, Brown to Dark Brown			
4	13	Clay, Light Brown			
13	22	Clay, Brown			
22	27	Clay, Brown to Red Brown			
27	33	Sand, Red Brown			
33	38	Clay, Light Red Brown			
38	41	Sand, White to Tan			
41	62	Sand, Light Red Brown			
62	75	Sand, Brown to Light Red Brown			
					SVE2 , Tag # 00175065 , Flushmount
					Project Name: Graham 66 Service
					GeoCore # 288 , KDHE # U6 032 513

7 CONTRACTOR'S OR LANDOWNER'S CERTIFICATION: This water well was **1** constructed, **2** reconstructed, or **3** plugged under my jurisdiction and was completed on (mo/day/year) **1/6/97** and this record is true to the best of my knowledge and belief.
 Kansas Water Well Contractor's License No. **527** This Water Well Record was completed on (mo/day/yr) **2/4/97**
 under the business name of **GeoCore Services, Inc.** by (signature) *Debbie A. Rob*