USE TYPEWRITER OR BALL POINT PEN-PRESS FIRMLY, PRINT CLEARLY.

T	R	EW	sec 1/4	1/4	1/4 No.

WATER WELL RECORD
KSA 82a-1201-1215

Kansas State Dept. Of Health
(Water Well Contractors)
Forbes-Bldg. 740
Topeka, Kansas 66620

1 Location of well:	County	Township name	Fraction	Section number	Town number	Range number
	GOVE	BAKER.	SW-NE-NE	25	11	26 W

Distance and direction from nearest town or city:

Street address of well location if in city:

3 Owner of well: REX RENECKER

Address: QUINTER KS

Locate with "X" in section below:

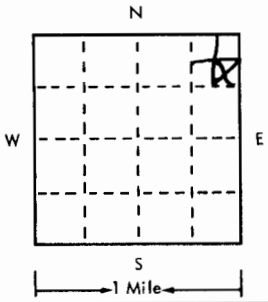

Sketch map:

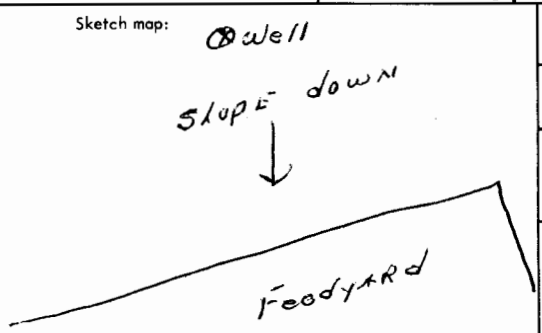

2 Type and color of material	From	To
Top soil	0	17
sandy clay	17	59
S. S.	59	63
sandy clay	63	79
gravel.	79	87
Ochre	87	91