


1 LOCATION OF WATER WELL: County: **Graham** Fraction: **NW 1/4 NW 1/4 NW 1/4** Section Number: **32** Township Number: **T 11 S** Range Number: **R 26 EW**

Distance and direction from nearest town or city street address of well if located within city?
I 70

2 WATER WELL OWNER: **Jimmy Graham**
RR#, St. Address, Box #: **P. O. Box 398**
City, State, ZIP Code: **Quinter, Ks. 67752**
Board of Agriculture, Division of Water Resources
MW # **12** Application Number:

3 LOCATE WELL'S LOCATION WITH AN "X" IN SECTION BOX:

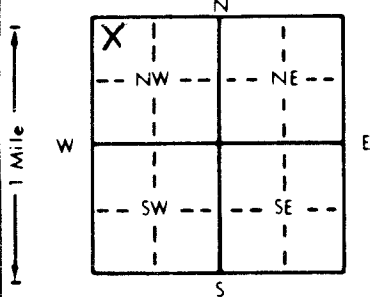

4 DEPTH OF COMPLETED WELL: **91** ft. ELEVATION: _____
Depth(s) Groundwater Encountered: 1. _____ ft. 2. _____ ft. 3. _____ ft.
WELL'S STATIC WATER LEVEL: **79** ft. below land surface measured on mo/day/yr _____
Pump test data: Well water was _____ ft. after _____ hours pumping _____ gpm
Est. Yield _____ gpm: Well water was _____ ft. after _____ hours pumping _____ gpm
Bore Hole Diameter: **8** in. to **91** ft., and _____ in. to _____ ft.
WELL WATER TO BE USED AS: 5 Public water supply 8 Air conditioning 11 Injection well
1 Domestic 3 Feedlot 6 Oil field water supply 9 Dewatering 12 Other (Specify below)
2 Irrigation 4 Industrial 7 Lawn and garden only 10 Monitoring well
Was a chemical/bacteriological sample submitted to Department? Yes _____ No **X** _____; If yes, mo/day/yr sample was submitted
Water Well Disinfected? Yes _____ No **X** _____

5 TYPE OF BLANK CASING USED:
1 Steel 3 RMP (SR) 5 Wrought iron 8 Concrete tile CASING JOINTS: Glued _____ Clamped _____
2 PVC 4 ABS 6 Asbestos-Cement 9 Other (specify below) Welded _____
Blank casing diameter: **2** in. to **66** ft., Dia _____ in. to _____ ft., Dia _____ in. to _____ ft.
Casing height above land surface: **0** in. weight **.716** lbs./ft. Wall thickness or gauge No. **154**
TYPE OF SCREEN OR PERFORATION MATERIAL:
1 Steel 3 Stainless steel 5 Fiberglass 7 PVC 10 Asbestos-cement
2 Brass 4 Galvanized steel 6 Concrete tile 8 RMP (SR) 11 Other (specify) _____
9 ABS 12 None used (open hole)
SCREEN OR PERFORATION OPENINGS ARE:
1 Continuous slot 3 Mill slot 5 Gauzed wrapped 8 Saw cut 11 None (open hole)
2 Louvered shutter 4 Key punched 6 Wire wrapped 9 Drilled holes
7 Torch cut 10 Other (specify) _____

SCREEN-PERFORATED INTERVALS: From **66** ft. to **91** ft., From _____ ft. to _____ ft.
GRAVEL PACK INTERVALS: From **62** ft. to **91** ft., From _____ ft. to _____ ft.
From _____ ft. to _____ ft., From _____ ft. to _____ ft.

6 GROUT MATERIAL: 1 Neat cement 2 Cement grout 3 Bentonite 4 Other _____
Grout Intervals: From **0** ft. to **58** ft., From **58** ft. to **62** ft., From _____ ft. to _____ ft.
What is the nearest source of possible contamination:
1 Septic tank 4 Lateral lines 7 Pit privy 10 Livestock pens 14 Abandoned water well
2 Sewer lines 5 Cess pool 8 Sewage lagoon 11 Fuel storage 15 Oil well/Gas well
3 Watertight sewer lines 6 Seepage pit 9 Feedyard 12 Fertilizer storage 16 Other (specify below)
13 Insecticide storage **Removed Fuel Storage**

Direction from well? _____ How many feet? _____

FROM	TO	LITHOLOGIC LOG	FROM	TO	PLUGGING INTERVALS
0	.6	Asphalt			
.6	13	Loess			
13	23	Clay w/Caliche Strks.			
23	29	Sand w/Clay & Some Cal. Strk.			
29	38	Tight Sand/Clay & Caliche			
38	40	Cemented Sand w/Clay&Cal			
40	44	Sand			
44	45	Caliche			
45	52	Med. Sand w/Clay Strks.			
52	64	Sandy Clay w/Caliche & Sand St.			
64	80	Med. Sand & Gravel			
80	91	Med. Sand & Gravel w/Clay Lenses			

7 CONTRACTOR'S OR LANDOWNER'S CERTIFICATION: This water well was (1) constructed, (2) reconstructed, or (3) plugged under my jurisdiction and was completed on (mo/day/year) **4-5-94** and this record is true to the best of my knowledge and belief. Kansas Water Well Contractor's License No. **554** This Water Well Record was completed on (mo/day/yr) **5-31-94** under the business name of **Woofter Pump & Well, Inc.** by (signature) *[Signature]*