


Plug MW-3

1 LOCATION OF WATER WELL: Fraction Section Number Township Number Range Number
 County: Gene NE 1/4 SE 1/4 NE 1/4 31 11 26 W

Distance and direction from nearest town or city street address of well if located within city?
1.70 3 Castle Rock Rd

2 WATER WELL OWNER: COASTAL MART # 2506
 RR #, St. Address, Box #: 9 Greenway Plaza
 City, State, ZIP Code: Houston, TX 77046
 Board of Agriculture, Division of Water Resources
 Application Number: _____

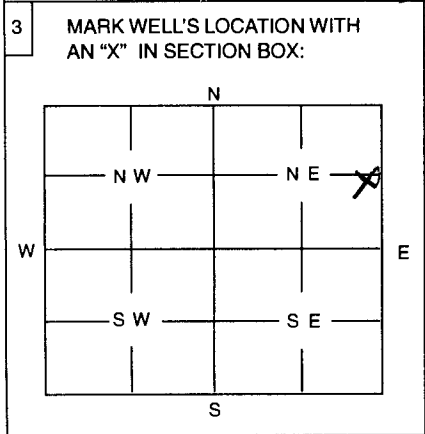

4 DEPTH OF WELL 85 ft
 WELL'S STATIC WATER LEVEL 67.05 ft.
 WELL WAS USED AS:
 1 Domestic 2 Irrigation 3 Feedlot 4 Industrial 5 Public Water Supply 6 Oil Field Water Supply 7 Domestic (Lawn & Garden) 8 Air Conditioning 9 Dewatering 10 Monitoring Well 11 Injection Well 12 Other
 Was a chemical / bacteriological sample submitted to Department? Yes No
 If yes, mo/day/yr sample was submitted
 Water Well Disinfected: Yes No

5 TYPE OF BLANK CASING USED:
 1 Steel 2 PVC 3 RMP (SR) 4 ABS 5 Wrought 6 Asbestos-Cement 7 Fiberglass 8 Concrete Tile 9 Other (Specify below)
 Blank casing diameter in. Was casing pulled? Yes No If yes, how much 3 ft
 Casing height above or below land surface flush in.

6 GROUT PLUG MATERIAL: 1 Neat cement 2 Cement grout 3 Bentonite 4 Other
 Grout Plug Intervals: From 67.05 ft. to 3 ft., From ft. to ft., From to ft.
 What is the nearest source of possible contamination:
 1 Septic tank 2 Sewer lines 3 Watertight sewer lines 4 Lateral lines 5 Cess Pool 6 Seepage pit 7 Pit privy 8 Sewage lagoon 9 Feedyard 10 Livestock pens 11 Fuel storage 12 Fertilizer storage 13 Insecticide storage 14 Abandoned water well 15 Oil well/Gas well 16 Other (specify below) contaminated side
 Direction from well? How many feet?

FROM	TO	PLUGGING MATERIALS
<u>85</u>	<u>67.05</u>	<u>chlor. sand</u>
<u>67.05</u>	<u>3</u>	<u>Bentonite</u>
<u>3</u>	<u>0</u>	<u>surface soils</u>

7 CONTRACTOR'S OR LANDOWNER'S CERTIFICATION: This water well was plugged under my jurisdiction and was completed on (mo/day/year) 3/27/01 and this record is true to the best of my knowledge and belief. Kansas Water Well Contractor's License No. 585 This Water Well Record was completed on (mo/day/year) 4/30/01 under the business name of AZ1 by (signature) Annette Fu Dain Dainco

INSTRUCTIONS: Use typewriter or ball point pen. Please press firmly and print clearly. Please fill in blanks, underline or circle the correct answers. Send top three copies to Kansas Department of Health and Environment, Bureau of Water, Topeka, Kansas 66620-0001. Telephone: 785/296-3565. Send one to Water Well Owner and retain one for your records.