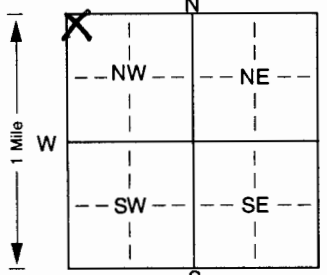


SVE-15

WATER WELL RECORD Form WWC-5 KSA 82a-1212 ID No.

00317869

1 LOCATION OF WATER WELL: Fraction <u>NW/4 NW 1/4 NW 1/4 NW 1/4</u> Section Number <u>32</u> Township Number <u>T 11 S</u> Range Number <u>R 26 EW</u>					
County: <u>Gove</u>					
Distance and direction from nearest town or city street address of well if located within city? <u>Intersection of I-70 and K 212, Quinter, KS</u>					
2 WATER WELL OWNER: <u>Jim Graham</u> RR#, St. Address, Box #: <u>P.O. Box 398</u> City, State, ZIP Code: <u>Quinter, KS 67752</u> Board of Agriculture, Division of Water Resources Application Number:					
3 LOCATE WELL'S LOCATION WITH AN "X" IN SECTION BOX: 	4 DEPTH OF COMPLETED WELL: <u>80</u> ft. ELEVATION: Depth(s) Groundwater Encountered 1. .... ft. 2. .... ft. 3. .... ft. WELL'S STATIC WATER LEVEL ..... ft. below land surface measured on mo/day/yr ..... Pump test data: Well water was ..... ft. after ..... hours pumping ..... gpm Est. Yield ..... gpm; Well water was ..... ft. after ..... hours pumping ..... gpm Bore Hole Diameter: <u>8</u> in. to <u>80</u> ft., and ..... in. to ..... ft. WELL WATER TO BE USED AS: 5 Public water supply 8 Air conditioning 11 Injection well 1 Domestic 3 Feedlot 6 Oil field water supply 9 Dewatering 12 Other (Specify below) 2 Irrigation 4 Industrial 7 Domestic (lawn & garden) <u>10 Monitoring well</u> <u>SVE (soil ventilation)</u> Was a chemical/bacteriological sample submitted to Department? Yes. <u>No</u> ; If yes, mo/day/yr sample was submitted Water Well Disinfected? Yes <u>No</u>				
5 TYPE OF BLANK CASING USED: 1 Steel 3 RMP (SR) 5 Wrought iron 8 Concrete tile CASING JOINTS: Glued. <u>X</u> Clamped. .... 2 PVC 4 ABS 6 Asbestos-Cement 9 Other (specify below) Welded ..... Blank casing diameter: <u>4.5</u> in. to <u>60</u> ft., Dia ..... in. to ..... ft., Dia ..... in. to ..... ft. Casing height above land surface ..... in., weight ..... lbs./ft. Wall thickness or gauge No. <u>sch. 40</u> TYPE OF SCREEN OR PERFORATION MATERIAL: <u>7 PVC</u> 10 Asbestos-cement 1 Steel 3 Stainless steel 5 Fiberglass 8 RMP (SR) 11 Other (specify) ..... 2 Brass 4 Galvanized steel 6 Concrete tile 9 ABS 12 None used (open hole) SCREEN OR PERFORATION OPENINGS ARE: 5 Gauzed wrapped 8 Saw cut 11 None (open hole) 1 Continuous slot 3 Mill slot 6 Wire wrapped 9 Drilled holes 2 Louvered shutter 4 Key punched 7 Torch cut 10 Other (specify) ..... ft. SCREEN-PERFORATED INTERVALS: From <u>60</u> ft. to <u>80</u> ft., From ..... ft. to ..... ft. GRAVEL PACK INTERVALS: From <u>57</u> ft. to <u>60</u> ft., From ..... ft. to ..... ft. From ..... ft. to ..... ft., From ..... ft. to ..... ft.					
6 GROUT MATERIAL: 1 Neat cement 52 2 Cement grout 3 Bentonite 4 Other ..... Grout Intervals: From <u>0</u> ft. to <u>52</u> ft., From ..... ft. to ..... ft., From ..... ft. to ..... ft. What is the nearest source of possible contamination: 1 Septic tank 4 Lateral lines 7 Pit privy 10 Livestock pens 14 Abandoned water well 2 Sewer lines 5 Cess pool 8 Sewage lagoon 11 Fuel storage 15 Oil well/Gas well 3 Watertight sewer lines 6 Seepage pit 9 Feedyard 12 Fertilizer storage 16 Other (specify below) Direction from well? ..... How many feet? .....					
FROM	TO	LITHOLOGIC LOG	FROM	TO	PLUGGING INTERVALS
0	10'	Very coarse silt. Light yellow- ish brown. Moist.	30'	35'	Same as above
10'	15'	Same as above with caliche nodules.	35'	45'	Same as above
15'	20'	coarse, sandy silt with abundant caliche nodules and carbon deposits. Tan. Moist.	45'	50'	Fine to very fine sand. Light brown. Moist.
20'	25'	Fine silty sand with a few coarse sand grains. Light yellowish brown. Some pebbles and caliche nodules. Moist.	50'	60'	Fine to med. grade sand. Light brown. Moist. With clay and caliche streaks and some large pebbles
25'	30'	Fine sand, very light yellowish-brown. Moist.	60'	70'	Fine to medium sand. Light brown. Moist to wet, with some clay streaks and small gravels. No odor
			70'	80'	Same as above; hydrocarbon odor.
7 CONTRACTOR'S OR LANDOWNER'S CERTIFICATION: This water well was (1) constructed, (2) reconstructed, or (3) plugged under my jurisdiction and was completed on (mo/day/year) <u>6-24-03</u> and this record is true to the best of my knowledge and belief. Kansas Water Well Contractor's Licence No. <u>SS4</u> This Water Well Record was completed on (mo/day/yr) <u>9-24-03</u> under the business name of <u>Woofler Pump &amp; Well</u> by (signature) <u>J. Woofler</u>					
INSTRUCTIONS: Use typewriter or ball point pen. PLEASE PRESS FIRMLY and PRINT clearly. Please fill in blanks, underline or circle the correct answers. Send top three copies to Kansas Department of Health and Environment, Bureau of Water, Topeka, Kansas 66620-0001. Telephone 785-296-5524. Send one to WATER WELL OWNER and retain one for your records. Fee of \$5.00 for each constructed well.					