


1) LOCATION OF WATER WELL: Fraction **NE 1/4 SE 1/4 NE 1/4** Section Number **31** Township Number **T 11 S** Range Number **R 26 E/W**
 County: **Gove**

Distance and direction from nearest town or city street address of well if located within city?
I-70 & Castle Rock Road, Quinter, Kansas

2) WATER WELL OWNER: **SEI PARTNERS, LP**
 RR#, St. Address, Box #: **PO Box 6929** Board of Agriculture, Division of Water Resources
 City, State, ZIP Code: **Shawnee Mission, KS 66206** Application Number:

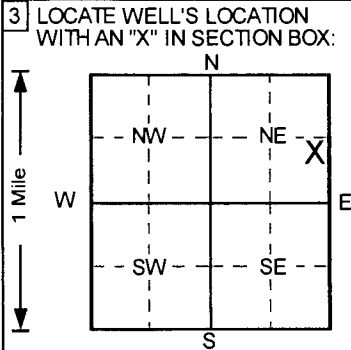

4) DEPTH OF COMPLETED WELL: **77** ft. ELEVATION: **0**
 Depth(s) Groundwater Encountered 1. ft. 2. ft. 3. ft.
 WELL'S STATIC WATER LEVEL: **66.2** ft. below land surface measured on **mo/day/yr** **3/9/2004**
 Pump test data: Well water was **NA** ft. after hours pumping gpm
 Est. Yield: **NA** gpm; Well water was ft. after hours pumping gpm
 Bore Hole Diameter: **4** in. to **77** ft., and in. to ft.
 WELL WATER TO BE USED AS:
 5 Public water supply 8 Air conditioning 11 Injection well
 1 Domestic 3 Feedlot 6 Oil field water supply 9 Dewatering **12 Other (Specify below)**
Vapor observation
 2 Irrigation 4 Industrial 7 Lawn and garden only 10 Monitoring well
 Was a chemical/bacteriological sample submitted to Department? Yes. No ; If yes, mo/day/yr sample was submitted
 Water Well Disinfected? Yes No

5) TYPE OF BLANK CASING USED:
 1 Steel 3 RMP (SR) 5 Wrought iron 8 Concrete tile CASING JOINTS: Glued Clamped
2 PVC 4 ABS 6 Asbestos-Cement 9 Other (specify below) Welded
 7 Fiberglass Threaded
 Blank casing diameter: **4** in. to **52** ft., Dia. in. to ft., Dia. in. to ft.
 Casing height above land surface: **0** in., weight lbs./ft. Wall thickness or gauge No. **Sch. 40**
 TYPE OF SCREEN OR PERFORATION MATERIAL
 1 Steel 3 Stainless steel 5 Fiberglass **7 PVC** 10 Asbestos-cement
 2 Brass 4 Galvanized steel 6 Concrete tile 8 RMP (SR) 11 Other (specify)
 12 None used (open hole)
 SCREEN OR PERFORATION OPENINGS ARE:
 1 Continuous slot **3 Mill slot** 5 Gauzed wrapped 8 Saw cut 11 None (open hole)
 2 Louvered shutter 4 Key punched 6 Wire wrapped 9 Drilled holes
 7 Torch cut 10 Other (specify)
 SCREEN-PERFORATED INTERVALS: From **52** ft. to **77** ft., From ft. to ft.
 From ft. to ft., From ft. to ft.
 GRAVEL PACK INTERVALS: From **49** ft. to **77** ft., From ft. to ft.
 From ft. to ft., From ft. to ft.

6) GROUT MATERIAL: 1 Neat cement **2 Cement grout** **3 Bentonite** 4 Other
 Grout Intervals: From **0** ft. to **46** ft., From **46** ft. to **49** ft., From ft. to ft.
 What is the nearest source of possible contamination:
 1 Septic tank 4 Lateral lines 7 Pit privy 10 Livestock pens 14 Abandoned water well
 2 Sewer lines 5 Cess pool 8 Sewage lagoon 11 Fuel storage 15 Oil well/Gas well
 3 Watertight sewer lines 6 Seepage pit 9 Feedyard 12 Fertilizer storage **16 Other (specify below)**
UST
 Direction from well? **West** How many feet? **70**

FROM	TO	LITHOLOGIC LOG	FROM	TO	PLUGGING INTERVALS
0	0.5	Asphalt			
0.5	2	Clay, silty, soft, damp, very plastic, Dark Gray			
2	15	Sand, silty, medium stiff, Light Brown			
15	25	Sand, clayey, stiff, moist, Reddish Brown			
25	35	Sand, fine to coarse grained, soft, Brown			
35	40	Sand, clayey, stiff, moist, Reddish Brown			
40	45	Sand, fine to coarse grained, soft, Brown			
45	50	Sand, fine to coarse grained, soft, Brown			
50	60	Silt, clayey, veri stiff, moist, Brown			
60	77	Sand, fine to med. grained, clayey, silty, Reddi			
					VOBW3, Tag # 00327255, Flushmount
					Project Name: Handex - Quinter
					GeoCore # 1123, #

7) CONTRACTOR'S OR LANDOWNER'S CERTIFICATION: This water well was **(1)** constructed, (2) reconstructed, or (3) plugged under my jurisdiction and was completed on (mo/day/year) **3/9/2004** and this record is true to the best of my knowledge and belief.
 Kansas Water Well Contractor's License No. **527** This Water Well Record was completed on (mo/day/yr) **3/30/2004**
 under the business name of **GeoCore, Inc.** by (signature) *Dave Hill*

OFFICE USE ONLY
T
R
EW
SEC
1/4
1/4
1/4