


1 LOCATION OF WATER WELL: Fraction **NE 1/4 SE 1/4 NE 1/4** Section Number **31** Township Number **T 11 S** Range Number **R 26 E 11W**
 County: **Gove**

Distance and direction from nearest town or city street address of well if located within city?
I-70 & Castle Rock Road, Quinter, Kansas

2 WATER WELL OWNER: **SEI PARTNERS, LP**
 RR#, St. Address, Box # : **PO Box 6929** Board of Agriculture, Division of Water Resources
 City, State, ZIP Code : **Shawnee Mission, KS 66206** Application Number:

3 LOCATE WELL'S LOCATION WITH AN "X" IN SECTION BOX:

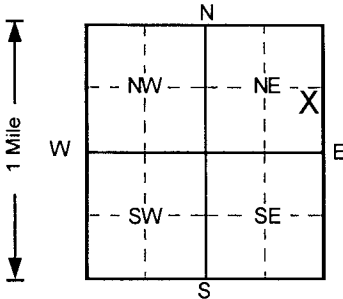

4 DEPTH OF COMPLETED WELL **77** ft. ELEVATION: **0**
 Depth(s) Groundwater Encountered 1. **66.18** ft. 2. **NA** ft. 3. **NA** ft.
 WELL'S STATIC WATER LEVEL **66.18** ft. below land surface measured on **mo/day/yr 3/9/2004**
 Pump test data: Well water was **NA** ft. after **NA** hours pumping **NA** gpm
 Est. Yield **NA** gpm: Well water was **NA** ft. after **NA** hours pumping **NA** gpm
 Bore Hole Diameter **8** in. to **77** ft., and **NA** in. to **NA** ft.
 WELL WATER TO BE USED AS: 5 Public water supply 8 Air conditioning 11 Injection well
 1 Domestic 3 Feedlot 6 Oil field water supply 9 Dewatering **12 Other (Specify below)**
Vapor observation
 2 Irrigation 4 Industrial 7 Lawn and garden only 10 Monitoring well
 Was a chemical/bacteriological sample submitted to Department? Yes No ; If yes, mo/day/yr sample was submitted
 Water Well Disinfected? Yes No

5 TYPE OF BLANK CASING USED: 1 Steel 3 RMP (SR) 5 Wrought iron 8 Concrete tile CASING JOINTS: Glued Clamped
2 PVC 4 ABS 6 Asbestos-Cement 9 Other (specify below) Welded
 7 Fiberglass Threaded

Blank casing diameter **4** in. to **52** ft., Dia. **4** in. to **52** ft., Dia. **4** in. to **52** ft.
 Casing height above land surface **0** in., weight **NA** lbs./ft. Wall thickness or gauge No. **Sch. 40**

TYPE OF SCREEN OR PERFORATION MATERIAL: 1 Steel 3 Stainless steel 5 Fiberglass **7 PVC** 10 Asbestos-cement
 2 Brass 4 Galvanized steel 6 Concrete tile 8 RMP (SR) 11 Other (specify)
 12 None used (open hole)

SCREEN OR PERFORATION OPENINGS ARE: 1 Continuous slot **3 Mill slot** 5 Gauzed wrapped 8 Saw cut 11 None (open hole)
 2 Louvered shutter 4 Key punched 6 Wire wrapped 9 Drilled holes
 7 Torch cut 10 Other (specify)

SCREEN-PERFORATED INTERVALS: From **52** ft. to **77** ft., From ft. to ft., From ft. to ft.
 GRAVEL PACK INTERVALS: From **49** ft. to **77** ft., From ft. to ft., From ft. to ft.

6 GROUT MATERIAL: 1 Neat cement **2 Cement grout** **3 Bentonite** 4 Other
 Grout Intervals: From **0** ft. to **46** ft., From **46** ft. to **49** ft., From ft. to ft.

What is the nearest source of possible contamination: 10 Livestock pens 14 Abandoned water well
 1 Septic tank 4 Lateral lines 7 Pit privy 11 Fuel storage 15 Oil well/Gas well
 2 Sewer lines 5 Cess pool 8 Sewage lagoon 12 Fertilizer storage **16 Other (specify below)**
 3 Watertight sewer lines 6 Seepage pit 9 Feedyard 13 Insecticide storage **UST**
 Direction from well? **West** How many feet? **120**

FROM	TO	LITHOLOGIC LOG	FROM	TO	PLUGGING INTERVALS
0	0.5	Asphalt,			
0.5	2	Clay, silty, soft, damp, very plastic, Dark Gray			
2	15	Sand, fine grained, silty, medium stiff, Light B			
15	20	Sand, fine grained, clayey, stiff, Reddish Brow			
20	25	Sand, fine grained with caliche, silty, Brown			
25	35	Sand, med. to coarse grained, soft, moist, Bro			
35	40	Sand, fine to coarse grained, clayey, Reddish			
40	45	Sand, fine to coarse grained, soft, moist, Brow			
45	50	Sand, fine to coarse grained, soft, moist, Brow			
50	60	Sand, fine to medium grained, clayey, silty, Br			
60	77	Sand, fine to med. grained, clayey, Reddish Br			
					VOBW2, Tag # 00327231, Flushmount
					Project Name: Handex - Quinter
					GeoCore # 1123, #

7 CONTRACTOR'S OR LANDOWNER'S CERTIFICATION: This water well was **1** constructed, **2** reconstructed, or **3** plugged under my jurisdiction and was completed on (mo/day/year) **3/9/2004** and this record is true to the best of my knowledge and belief.
 Kansas Water Well Contractor's License No. **527**. This Water Well Record was completed on (mo/day/yr) **3/30/2004** under the business name of **GeoCore, Inc.** by (signature) *Paul R. [Signature]*