


1 LOCATION OF WATER WELL: County: Gove	Fraction NE ¼ SE ¼ NE ¼	Section Number 31	Township Number T 11 S	Range Number R 26 W
--	-----------------------------------	-----------------------------	----------------------------------	-------------------------------

Distance and direction from nearest town or city street address of well if located within city?
I-70 & Castle Rock Road, Quinter

2 WATER WELL OWNER: RR#, St. Address, Box # : City, State, ZIP Code :	Coastal Mart #2506 9 Greenway Plaza Houston, TX 77046	Board of Agriculture, Division of Water Resources Application Number:
---	--	--

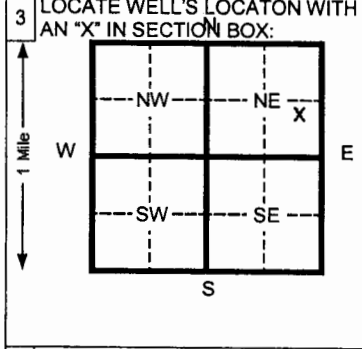

4 DEPTH OF COMPLETED WELL Depth(s) Groundwater Encountered 1 _____ ft. 2 _____ ft. 3 _____ ft. WELL'S STATIC WATER LEVEL _____ ft. below land surface measured on mo/day/yr _____ Pump test data: Well water was _____ ft. after _____ hours pumping _____ gpm Est. Yield _____ gpm: Well water was _____ ft. after _____ hours pumping _____ gpm Bore Hole Diameter 8.5 in. to 77 ft. and _____ in. to _____ ft. WELL WATER TO BE USED AS: 5 Public water supply 8 Air conditioning 11 Injection well 1 Domestic 3 Feed lot 6 Oil field water supply 9 Dewatering 12 Other (Specify below) 2 Irrigation 4 Industrial 7 Lawn and garden (domestic) 10 Monitoring well Air Sparge
Was a chemical/bacteriological sample submitted to Department? Yes _____ No X If yes, mo/day/yr sample was submitted _____ Water Well Disinfected? Yes _____ No X

5 TYPE OF BLANK CASING USED: 1 Steel 3 RMP (SR) 2 PVC 4 ABS Blank casing diameter 2 in. to 75 ft., Dia _____ in. to _____ ft., Dia _____ in. to _____ ft. Casing height above land surface Flushmount in., weight 0.703 lbs./ft. Wall thickness or gauge No. Sch. 40	5 Wrought Iron 8 Concrete tile CASING JOINTS: Glued _____ Clamped _____ 6 Asbestos-Cement 9 Other (specify below) Welded _____ 7 Fiberglass _____ Threaded Flush
--	---

TYPE OF SCREEN OR PERFORATION MATERIAL: 1 Steel 3 Stainless steel 5 Fiberglass 8 RMP (SR) 11 Other (specify) 2 Brass 4 Galvanized steel 6 Concrete tile 9 ABS 12 None used (open hole)	7 PVC 10 Asbestos-cement
SCREEN OR PERFORATION OPENINGS ARE: 1 Continuous slot 3 Mill slot 6 Wire wrapped 9 Drilled holes 2 Louvered shutter 4 Key punched 7 Torch cut 10 Other (specify) 5 Gauzed wrapped 8 Saw cut 11 None (open hole)	
SCREEN-PERFORATED INTERVALS: From 75 ft. to 77 ft. From _____ ft. to _____ ft. From _____ ft. to _____ ft. From _____ ft. to _____ ft.	
GRAVEL PACK INTERVALS: From 72 ft. to 77 ft. From _____ ft. to _____ ft. From _____ ft. to _____ ft. From _____ ft. to _____ ft.	

6 GROUT MATERIAL: 1 Neat cement 2 Cement grout 3 Bentonite 4 Other _____ Grout Intervals From 0.5 ft. to 70 ft. From 70 ft. to 72 ft. From _____ ft. to _____ ft.
--

What is the nearest source of possible contamination:

1 Septic tank	4 Lateral lines	7 Pit privy	10 Livestock pens	14 Abandoned water well
2 Sewer lines	5 Cess pool	8 Sewage lagoon	11 Fuel storage	15 Oil well/ Gas well
3 Watertight sewer lines	6 Seepage pit	9 Feedyard	12 Fertilizer storage	16 Other (specify below)
			13 Insecticide storage	

FROM	TO	CODE	LITHOLOGIC LOG	FROM	TO	PLUGGING INTERVALS
0	0.5		Concrete			
0.5	1		Clay			
1	25		Silty Clay			
25	26.5		Clayey Sand			
26.5	35		Sand			
35	40		Clayey Sand			
40	50		Sand			
50	71.5		Sandy Clay			
71.5	77		Sand			

7 CONTRACTOR'S OR LANDOWNER'S CERTIFICATION: This water well was (1) constructed , (2) reconstructed, or (3) plugged under my jurisdiction and was completed on (mo/day/yr) 10-19-05 and this record is true to the best of my knowledge and belief, Kansas Water Well Contractor's License No. 531 This Water Well Record was completed on (mo/day/yr) 11-30-05 under the business name of Geotechnical Services, Inc. by (signature) <i>Alison W. [Signature]</i>
--

INSTRUCTIONS: Please fill in blanks and circle the correct answers. Send three copies to Kansas Department of Health and Environment, Bureau of Water, 1000 S W Jackson St., Ste. 420, Topeka, Kansas 66612-1367. Telephone: 913-296-5545. Send one to WATER WELL OWNER and retain one for your records.