


1 LOCATION OF WATER WELL: County: Gove	Fraction NE ¼ SE ¼ NE ¼	Section Number 31	Township Number T 11 S	Range Number R 26 W
--	-----------------------------------	-----------------------------	----------------------------------	-------------------------------

Distance and direction from nearest town or city street address of well if located within city?
I-70 & Castle Rock Road, Quinter

2 WATER WELL OWNER: RR#, St. Address, Box # : City, State, ZIP Code :	Coastal Mart #2506 9 Greenway Plaza Houston, TX 77046	Board of Agriculture, Division of Water Resources Application Number:
---	--	--

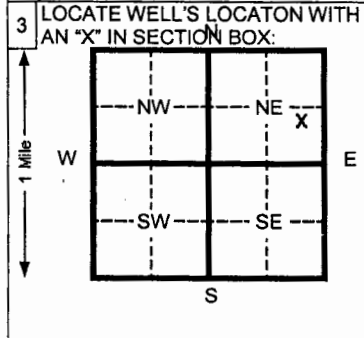

4 DEPTH OF COMPLETED WELL 70 ft. ELEVATION: _____	Depth(s) Groundwater Encountered 1 _____ ft. 2 _____ ft. 3 _____ ft.
WELL'S STATIC WATER LEVEL _____ ft. below land surface measured on mo/day/yr	
Pump test data: Well water was _____ ft. after _____ hours pumping _____ gpm	
Est. Yield _____ gpm: Well water was _____ ft. after _____ hours pumping _____ gpm	
Bore Hole Diameter 12.5 in. to 70 ft. and _____ in. to _____ ft.	
WELL WATER TO BE USED AS: 5 Public water supply 8 Air conditioning 11 Injection well	
1 Domestic 3 Feed lot 6 Oil field water supply 9 Dewatering 12 Other (Specify below)	
2 Irrigation 4 Industrial 7 Lawn and garden (domestic) 10 Monitoring well Soil Vapor Extraction	
Was a chemical/bacteriological sample submitted to Department? Yes _____ No X If yes, mo/day/yr sample was submitted	
Water Well Disinfected? Yes _____ No X	

5 TYPE OF BLANK CASING USED: 1 Steel 3 RMP (SR) 2 PVC 4 ABS	5 Wrought Iron 8 Concrete tile 6 Asbestos-Cement 9 Other (specify below) 7 Fiberglass	CASING JOINTS: Glued _____ Clamped _____ Welded _____ Threaded Flush
Blank casing diameter 4 in. to 55 ft., Dia _____ in. to _____ ft., Dia _____ in. to _____ ft.		
Casing height above land surface Flushmount in., weight _____ 2.0 lbs./ft. Wall thickness or gauge No. Sch. 40		
TYPE OF SCREEN OR PERFORATION MATERIAL: 7 PVC 10 Asbestos-cement		
1 Steel 3 Stainless steel 5 Fiberglass 8 RMP (SR) 11 Other (specify) _____		
2 Brass 4 Galvanized steel 6 Concrete tile 9 ABS 12 None used (open hole)		
SCREEN OR PERFORATION OPENINGS ARE: 1 Continuous slot 3 Mill slot 6 Wire wrapped 9 Drilled holes		
2 Louvered shutter 4 Key punched 7 Torch cut 10 Other (specify) _____		
SCREEN-PERFORATED INTERVALS: From 55 ft. to 70 ft. From _____ ft. to _____ ft.		
GRAVEL PACK INTERVALS: From 54 ft. to 70 ft. From _____ ft. to _____ ft.		

6 GROUT MATERIAL: 1 Neat cement 2 Cement grout 3 Bentonite 4 Other _____	Grout Intervals From 0.5 ft. to 51 ft. From 51 ft. to 54 ft. From _____ ft. to _____ ft.
What is the nearest source of possible contamination: 1 Septic tank 4 Lateral lines 7 Pit privy 10 Livestock pens 14 Abandoned water well	
2 Sewer lines 5 Cess pool 8 Sewage lagoon 11 Fuel storage 15 Oil well/ Gas well	
3 Watertight sewer lines 6 Seepage pit 9 Feedyard 12 Fertilizer storage 16 Other (specify below) _____	
Direction from well? _____ How many feet? _____	

FROM	TO	CODE	LITHOLOGIC LOG	FROM	TO	PLUGGING INTERVALS
0	0.5		Concrete			
0.5	1		Clay			
1	25		Silty Clay			
25	30		Clayey Sand			
30	35		Sand			
35	45		Clayey Sand			
45	53		Sand			
53	63		Sandy Clay			
63	70		Clayey Sand			

7 CONTRACTOR'S OR LANDOWNER'S CERTIFICATION: This water well was (1) constructed , (2) reconstructed, or (3) plugged under my jurisdiction and was completed on (mo/day/yr) 10-21-05 and this record is true to the best of my knowledge and belief. Kansas Water Well Contractor's License No. 531 This Water Well Record was completed on (mo/day/yr) 11-30-05 under the business name of Geotechnical Services, Inc. by (signature) _____
