


1 LOCATION OF WATER WELL: Fraction NE 1/4 NE 1/4 SE 1/4 Section Number 30 Township Number T 11 S Range Number R 26 EW
 County: Gove

Distance and direction from nearest town or city street address of well if located within city?
500 McKinney St.

2 WATER WELL OWNER: Doug Gruenbacher
 RR#, St. Address, Box #: 500 McKinney St. Board of Agriculture, Division of Water Resources
 City, State, ZIP Code: Quinter, KS 67792 Application Number:

3 LOCATE WELL'S LOCATION WITH AN "X" IN SECTION BOX: 4 DEPTH OF COMPLETED WELL 133 ft. ELEVATION:

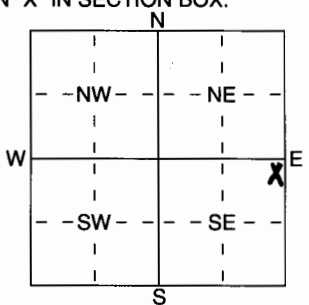

Depth(s) Groundwater Encountered: 87 ft. 2 ft. 3 ft.
 WELL'S STATIC WATER LEVEL 87 ft. below land surface measured on mo/day/yr
 Pump test data: Well water was ft. after hours pumping gpm
 Est. Yield 30 gpm: Well water was ft. after hours pumping gpm
 WELL WATER TO BE USED AS: 5 Public water supply 8 Air conditioning 11 Injection well
 Domestic 3 Feedlot 6 Oil field water supply 9 Dewatering 12 Other (Specify below)
 2 Irrigation 4 Industrial 7 Domestic (lawn & garden) 10 Monitoring well

Was a chemical/bacteriological sample submitted to Department? Yes No If yes, mo/day/yr sample was submitted
 Water Well Disinfected? Yes No

5 TYPE OF BLANK CASING USED: 5 Wrought iron 8 Concrete tile CASING JOINTS: Glued Clamped
 1 Steel 3 RMP (SR) 6 Asbestos-Cement 9 Other (specify below) Welded
 PVC 4 ABS 7 Fiberglass Threaded

Blank casing diameter in. to 113 ft., Dia in. to ft., Dia in. to ft.
 Casing height above land surface 24 in., weight 1100 lbs./ft. Wall thickness or gauge No. SDR 26

TYPE OF SCREEN OR PERFORATION MATERIAL: 7 PVC 10 Asbestos-Cement
 1 Steel 3 Stainless Steel 5 Fiberglass 8 RMP (SR) 11 Other (Specify)
 2 Brass 4 Galvanized Steel 6 Concrete tile 9 ABS 12 None used (open hole)

SCREEN OR PERFORATION OPENINGS ARE: 5 Gauzed wrapped 8 Saw cut 11 None (open hole)
 1 Continuous slot 3 Mill slot 6 Wire wrapped 9 Drilled holes
 2 Louvered shutter 4 Key punched 7 Torch cut 10 Other (specify)

SCREEN-PERFORATED INTERVALS: From 113 ft. to 133 ft., From ft. to ft.
 GRAVEL PACK INTERVALS: From 100 ft. to 133 ft., From ft. to ft.

6 GROUT MATERIAL: 1 Neat cement 2 Cement grout 3 Bentonite 4 Other
 Grout Intervals: From 0 ft. to 22 ft., From ft. to ft., From ft. to ft.

What is the nearest source of possible contamination:
 1 Septic tank 4 Lateral lines 7 Pit privy 10 Livestock pens 14 Abandoned water well
 2 Sewer lines 5 Cess pool 8 Sewage lagoon 11 Fuel storage 15 Oil well/Gas well
 Watertight sewer lines 6 Seepage pit 9 Feedyard 12 Fertilizer storage 16 Other (specify below)
 13 Insecticide storage

Direction from well? North How many feet? 250

FROM	TO	LITHOLOGIC LOG	FROM	TO	PLUGGING INTERVALS
0	5	topsoil	96	98	fine sand
5	28	tan clay	98	105	gray clay
28	45	sand	105	108	fine sand
45	55	sandy clay	108	118	coarse sand
55	67	medium sand	118	120	clay
67	74	gray clay	120	129	coarse sand
74	78	sand	129	131	yellow clay
78	79	white rock	131	133	rock
79	82	sand			
82	85	brown clay			
85	88	coarse sand			
88	89	white rock			
89	93	sand			
93	96	gray clay			

7 CONTRACTOR'S OR LANDOWNER'S CERTIFICATION: This water well was constructed, reconstructed, or plugged under my jurisdiction and was completed on (mo/day/year) 5-23-06 and this record is true to the best of my knowledge and belief. Kansas Water Well Contractor's Licence No. 489 This Water Well Record was completed on (mo/day/yr) 6-30-06 under the business name of Aqua Pump by (signature) Van M Jurek