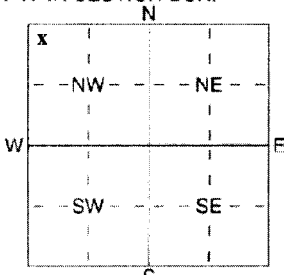


1 LOCATION OF WATER WELL: County: **Gove** Fraction: **NW 1/4 NW 1/4 NW 1/4** Section Number: **32** Township Number: **T 11 S** Range Number: **R 26 E 1W**

Distance and direction from nearest town or city street address of well if located within city?
Junction of Castle Rock Road & Kansas Hwy 212, Quinter, Kansas


2 WATER WELL OWNER: **Grahams 66**
 RR# St. Address, Box # : **Interstate 70 & Castle Rock Road**
 City, State, ZIP Code : **Quinter, KS 67752**
 Board of Agriculture, Division of Water Resources
 Application Number:

3 LOCATE WELL'S LOCATION WITH AN "X" IN SECTION BOX:  4 DEPTH OF COMPLETED WELL: **89.9** ft. ELEVATION: **2659**
 Depth(s) Groundwater Encountered 1 **74.96** ft. 2 ft. 3 ft.
 WELL'S STATIC WATER LEVEL **74.96** ft. below land surface measured on mo/day/yr **06-13-2006**
 Pump test data: Well water was ft. after hours pumping gpm
 Est. Yield **.5** gpm: Well water was ft. after hours pumping gpm
 WELL WATER TO BE USED AS: 5 Public water supply 8 Air conditioning 11 Injection well
 1 Domestic 3 Feedlot 6 Oil field water supply 9 Dewatering **02-7** 12 Other (Specify below)
 2 Irrigation 4 Industrial 7 Domestic (lawn & garden) **10** Monitoring well
 Was a chemical/bacteriological sample submitted to Department? Yes No **x** ; If yes, mo/day/yrs sample was submitted
 Water Well Disinfected? Yes No **x**

5 TYPE OF BLANK CASING USED: 1 Steel 3 RMP (SR) 5 Wrought iron 8 Concrete tile CASING JOINTS: Glued Clamped
2 PVC 4 ABS 6 Asbestos-Cement 9 Other (specify below) Welded
 Blank casing diameter **2** in. to **89.9** ft., Dia in. to ft., Dia in. to ft.
 Casing height above land surface **-0.2 below** in., weight **0.70** lbs./ft. Wall thickness or gauge No. **sch 40**
 TYPE OF SCREEN OR PERFORATION MATERIAL: 1 Steel 3 Stainless Steel 5 Fiberglass **7** PVC 10 Asbestos-Cement
 2 Brass 4 Galvanized Steel 6 Concrete tile 8 RMP (SR) 11 Other (Specify)
 9 ABS 12 None used (open hole)
 SCREEN OR PERFORATION OPENINGS ARE: 5 Gauzed wrapped 8 Saw cut 11 None (open hole)
 1 Continuous slot **3** Mill slot 6 Wire wrapped 9 Drilled holes
 2 Louvered shutter 4 Key punched 7 Torch cut 10 Other (specify) ft.
 SCREEN-PERFORATED INTERVALS: From **87.9** ft. to **89.9** ft., From ft. to ft.
 GRAVEL PACK INTERVALS: From **.85** ft. to **89.9** ft., From ft. to ft.

6 GROUT MATERIAL: 1 Neat cement 2 Cement grout **3** Bentonite 4 Other
 Grout Intervals: From **85** ft. to **1** ft., From **1** ft. to **0 concrete** ft., From ft. to ft.
 What is the nearest source of possible contamination:
 1 Septic tank 4 Lateral lines 7 Pit privy **11** Fuel storage 14 Abandoned water well
 2 Sewer lines 5 Cess pool 8 Sewage lagoon 12 Fertilizer storage 15 Oil well/Gas well
 3 Watertight sewer lines 6 Seepage pit 9 Feedyard 13 Insecticide storage 16 Other (specify below)
 Direction from well? **East** How many feet? **150**

FROM	TO	LITHOLOGIC LOG	FROM	TO	PLUGGING INTERVALS
0	1	topsoil and fill			
1	17	Silt			
17	23	Clayey Silt			
23	55	Sand			
55	80	Sandstone			
80	89.9	Sand			

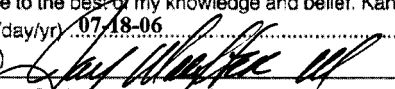7 CONTRACTOR'S OR LANDOWNER'S CERTIFICATION: This water well was **1** constructed, (2) reconstructed, or (3) plugged under my jurisdiction and was completed on (mo/day/year) **06-13-06** and this record is true to the best of my knowledge and belief. Kansas Water Well Contractor's Licence No **554** This Water Well Record was completed on (mo/day/yr) **07-18-06** under the business name of **Woofter Pump & Well, Inc.** by (signature) 

INSTRUCTIONS: Use typewriter or ball point pen. PLEASE PRESS FIRMLY and PRINT clearly. Please fill in blanks, underline or circle the correct answers. Send two copies to Kansas Department of Health and Environment, Bureau of Water, Geology Section, 1000 SW Jackson St., Suite 420, Topeka, Kansas 66612-1367. Telephone 785-296-5522. Send one to WATER WELL OWNER and retain one for your records. Fee of \$5.00 for each completed well.