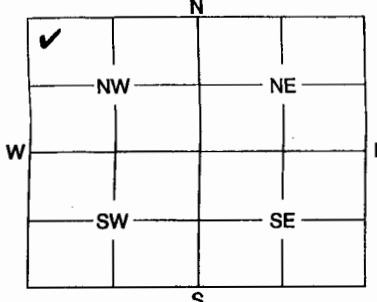


1 LOCATION OF WATER WELL:	Fraction	Section Number	Township Number	Range Number
County: Gove	NW ¼ NW ¼ NW ¼	32	11	26 EW

Distance and direction from nearest town or city street address of well if located within city?
I - 70 & Hwy K212 Wuinters

2 WATER WELL OWNER: Jim Graham	Board of Agriculture, Division of Water Resources
RR #, St. Address, Box #: Box 398	Application Number:
City, State, ZIP Code: Quinter, Knasas 67752	

3 MARK WELL'S LOCATION WITH AN "X" IN SECTION BOX:	4 DEPTH OF WELL <u>93.5</u> ft.											
	WELL'S STATIC WATER LEVEL ft.											
	WELL WAS USED AS:											
	<table style="width:100%; border:none;"> <tr> <td style="width:33%;">1 Domestic</td> <td style="width:33%;">5 Public Water Supply</td> <td style="width:33%;">9 Dewatering</td> </tr> <tr> <td>2 Irrigation</td> <td>6 Oil Field Water Supply</td> <td>10 Monitoring Well</td> </tr> <tr> <td>3 Feedlot</td> <td>7 Domestic (Lawn & Garden)</td> <td>11 Injection Well</td> </tr> <tr> <td>4 Industrial</td> <td>8 Air Conditioning</td> <td>12 Other <u>ASP-10</u></td> </tr>
Was a chemical / bacteriological sample submitted to Department? Yes No <input checked="" type="checkbox"/> If yes, mo/day/yr sample was submitted Water Well Disinfected: Yes No <input checked="" type="checkbox"/>												

5 TYPE OF BLANK CASING USED:

1 Steel	3 RMP (SR)	5 Wrought	7 Fiberglass	9 Other (Specify below)
2 PVC	4 ABS	6 Asbestos-Cement	8 Concrete Tile	

Blank casing diameter 2 in. Was casing pulled? Yes No If yes, how much 3'

Casing height above or below land surface in.

6 GROUT PLUG MATERIAL: 1 Neat cement 2 Cement grout 3 Bentonite 4 Other asphalt millings

Grout Plug Intervals: From 93.5 ft. to 0.75 ft., From 0.75 ft. to 0 ft., From to ft.

What is the nearest source of possible contamination:

1 Septic tank	6 Seepage pit	11 Fuel storage	16 Other (specify below)
2 Sewer lines	7 Pit privy	12 Fertilizer storage	<u>Surface</u>
3 Watertight sewer lines	8 Sewage lagoon	13 Insecticide storage	
4 Lateral lines	9 Feedyard	14 Abandoned water well	
5 Cess pool	10 Livestock pens	15 Oil well/Gas well	

Direction from well? How many feet?

FROM	TO	PLUGGING MATERIALS
0	0.75	Asphalt Millings
0.75	93.5	Bentonite Slurry

7 CONTRACTOR'S OF LANDOWNER'S CERTIFICATION: This water well was plugged under my jurisdiction and was completed on (mo/day/year) 10-10-06 and this record is true to the best of my knowledge and belief. Kansas Water Well Contractor's License No. 735 This Water Well Record was completed on (mo/day/year) 10-26-06 under the business name of MILCO Environmental Services, Inc.

by (signature) [Signature]

INSTRUCTIONS: Use typewriter or ball point pen. Please press firmly and print clearly. Please fill in blanks, underline or circle the correct answers. Send top three copies to Kansas Department of Health and Environment, Bureau of Water, Geology Section, 1000 SW Jackson St., Ste. 420, Topeka, Kansas 66612-1367. Telephone: 785/296-5522. Send one to Water Well Owner and retain one for your records.