

**WATER WELL PLUGGING RECORD Form WWC-5P KSA 82a-1212 ID NO.**


<b>1 LOCATION OF WATER WELL:</b> County: <u>Gove</u>	Fraction <u>NW 1/4 NW 1/4 NW 1/4</u> 1/4	Section Number <u>32</u>	Township Number <u>T 11 S</u>	Range Number <u>26</u> <input type="checkbox"/> E <input checked="" type="checkbox"/> W
---	---	-----------------------------	----------------------------------	--

Street/Rural Address of Well Location; if unknown, distance & direction from nearest town or intersection: If at owner's address, check here  Junction of Castle Rock Road & Kansas Hwy 212, Quinter, Kansas

**Global Positioning Systems (GPS) information:**  
 Latitude: \_\_\_\_\_ (in decimal degrees)  
 Longitude: \_\_\_\_\_ (in decimal degrees)  
 Elevation: \_\_\_\_\_  
 Horizontal Datum:  WGS84,  NAD83,  NAD27  
 Collection Method: \_\_\_\_\_

**2 WATER WELL OWNER:** Grahams 66  
 RR#, St. Address, Box #: Interstate 70 & Castle Rock Road  
 City, State ZIP Code: Quinter, KS 67752

GPS unit (Make/Model): \_\_\_\_\_  
 Digital Map/Photo,  Topographic Map,  Land Survey  
 Est. Accuracy:  < 3 m,  3-5 m,  5-15 m,  > 15 m

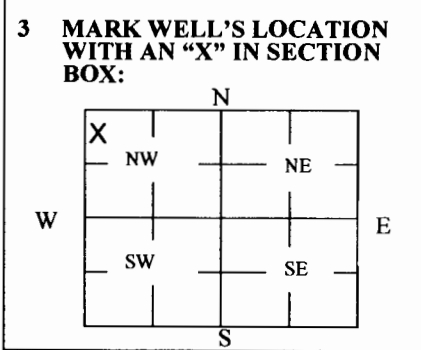

**4 DEPTH OF WELL** 88.40 ft.  
 WELL'S STATIC WATER LEVEL 76.30 ft

WELL WAS USED AS:

<input type="checkbox"/> Domestic	<input type="checkbox"/> Public Water Supply	<input type="checkbox"/> Dewatering
<input type="checkbox"/> Irrigation	<input type="checkbox"/> Oil Field Water Supply	<input checked="" type="checkbox"/> Monitoring OZ-3
<input type="checkbox"/> Feedlot	<input type="checkbox"/> Domestic (Lawn & Garden)	<input type="checkbox"/> Injection Well
<input type="checkbox"/> Industrial	<input type="checkbox"/> Air Conditioning	<input type="checkbox"/> Other _____

Was a chemical/bacteriological sample submitted to Department? Yes  No

**5 TYPE OF BLANK CASING USED:**

<input checked="" type="checkbox"/> Steel PVC	<input type="checkbox"/> RMP (SR) ABS	<input type="checkbox"/> Wrought Asbestos-Cement	<input type="checkbox"/> Fiberglass Concrete Tile	<input type="checkbox"/> Other (Specify below) _____
---	---------------------------------------	--	---	--

Blank casing diameter 2 in. Was casing pulled? Yes  No  If yes, how much 3'  
 Casing height above or below land surface 36 in.

**6 GROUT PLUG MATERIAL:**  Neat cement  Cement grout  Bentonite  Other \_\_\_\_\_

Grout Plug Intervals: From 3 ft. to 88.40 ft., From \_\_\_\_\_ ft. to \_\_\_\_\_ ft., From \_\_\_\_\_ ft. to \_\_\_\_\_ ft.

What is the nearest source of possible contamination:

<input type="checkbox"/> Septic tank	<input type="checkbox"/> Seepage pit	<input checked="" type="checkbox"/> Fuel storage	<input type="checkbox"/> Other (specify below) _____
<input type="checkbox"/> Sewer lines	<input type="checkbox"/> Pit privy	<input type="checkbox"/> Fertilizer storage	
<input type="checkbox"/> Watertight sewer lines	<input type="checkbox"/> Sewage lagoon	<input type="checkbox"/> Insecticide storage	
<input type="checkbox"/> Lateral lines	<input type="checkbox"/> Feedyard	<input type="checkbox"/> Abandoned water well	Direction from well? _____
<input type="checkbox"/> Cess pool	<input type="checkbox"/> Livestock pens	<input type="checkbox"/> Oil well/Gas well	How many feet? _____

FROM	TO	PLUGGING MATERIALS	FROM	TO	PLUGGING MATERIALS
0	3	Native soil			
3	88.40	Bentonite grout			

**7 CONTRACTOR'S OR LANDOWNER'S CERTIFICATION:** This water well was plugged under my jurisdiction and was completed on (mo/day/year) 4-25-16 and this record is true to the best of my knowledge and belief. Kansas Water Well Contractor's License No. 735. This Water Well Record was completed on (mo/day/year) 6-17-16 under the business name of MILCO Environmental Services, Inc. by (signature) *Tracy J. Shelton*



# MILCO

**Environmental Services, Inc.**

June 21, 2016

320 West 4th Street  
Colby, KS 67701  
Tel: 785-460-1956  
Fax: 785-460-4220  
www.milcoinc.com

Kansas Department of Health and Environment  
Bureau of Water - GWTS  
1000 SW Jackson St, Ste 420  
Topeka, KS 66612-1367

RE:

One Stop/Agro Petro/Travel Shoppe #3 - Oakley, Kansas  
KDHE Project Code U6-055-295/A6-055-40009/U6-055-11737  
MILCO Project No. M250-P1-01

Graham's 66 Service - Quinter, Kansas  
KDHE Project Code: U6-032-00513  
MILCO Project No. M269-P1-01

Holiday 66/I-C 66  
KDHE Project Codes U6-026-00663/U6-026-14849  
MILCO Project No. M273-P8-01

Dear Sir or Madam:


Please find enclosed one (1) Water Well Plugging Record for the One Stop/Agro Petro/Travel Shoppe #3 site in Oakley. The well was abandoned by MILCO on May 20, 2016.

Please find enclosed fourteen (14) Water Well Plugging Records for the Holiday 66 site in Hays. The wells were abandoned by MILCO on June 1, 2016.

Please find enclosed twenty-five (25) Water Well Plugging Records for the Grahams 66 site in Quinter. The wells were abandoned by MILCO on April 25 and June 3, 2016.

If you need any additional information, please don't hesitate to contact us.

Respectfully submitted,  
**MILCO Environmental Services, Inc.**

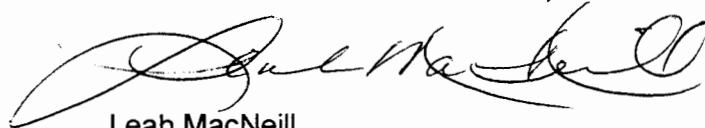

Leah MacNeill

Enclosures

RECEIVED  
JUN 23 2016  
BUREAU OF WATER