


1 LOCATION OF WATER WELL: County: <u>Gove</u>	Fraction <u>NW 1/4 NW 1/4 NW 1/4</u> 1/4	Section Number <u>32</u>	Township Number <u>T 11 S</u>	Range Number <u>26</u> <input type="checkbox"/> E <input checked="" type="checkbox"/> W
---	---	-----------------------------	----------------------------------	--

Street/Rural Address of Well Location; if unknown, distance & direction from nearest town or intersection: If at owner's address, check here I-70 and Hwy K212 - Quinter, KS

Global Positioning Systems (GPS) information:
 Latitude: _____ (in decimal degrees)
 Longitude: _____ (in decimal degrees)
 Elevation: _____
 Horizontal Datum: WGS84, NAD83, NAD27
 Collection Method: _____

2 WATER WELL OWNER: Jim Graham RR#, St. Address, Box #: P.O. Box 507 City, State ZIP Code: Quinter, KS 67752	<input type="checkbox"/> GPS unit (Make/Model: _____) <input type="checkbox"/> Digital Map/Photo, <input type="checkbox"/> Topographic Map, <input type="checkbox"/> Land Survey Est. Accuracy: <input type="checkbox"/> < 3 m, <input type="checkbox"/> 3-5 m, <input type="checkbox"/> 5-15 m, <input type="checkbox"/> > 15 m
---	--

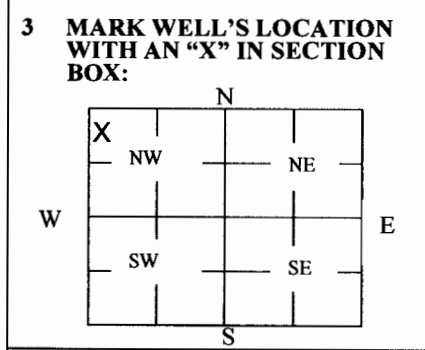

4 DEPTH OF WELL 72.30 ft.
 WELL'S STATIC WATER LEVEL DRY ft
 WELL WAS USED AS:
 Domestic Public Water Supply Dewatering
 Irrigation Oil Field Water Supply Monitoring
 Feedlot Domestic (Lawn & Garden) Injection Well SVE-6
 Industrial Air Conditioning Other Soil Vapor Extraction

Was a chemical/bacteriological sample submitted to Department? Yes No

5 TYPE OF BLANK CASING USED:

Steel RMP (SR) Wrought Fiberglass Other (Specify below) _____
 PVC ABS Asbestos-Cement Concrete Tile

Blank casing diameter 2 in. Was casing pulled? Yes No If yes, how much _____
 Casing height above or below land surface 18 in.

6 GROUT PLUG MATERIAL: Neat cement Cement grout Bentonite Other _____

Grout Plug Intervals: From 3 ft. to 72.30 ft., From _____ ft. to _____ ft., From _____ ft. to _____ ft.

What is the nearest source of possible contamination:

<input type="checkbox"/> Septic tank	<input type="checkbox"/> Seepage pit	<input checked="" type="checkbox"/> Fuel storage	<input type="checkbox"/> Other (specify below) _____
<input type="checkbox"/> Sewer lines	<input type="checkbox"/> Pit privy	<input type="checkbox"/> Fertilizer storage	
<input type="checkbox"/> Watertight sewer lines	<input type="checkbox"/> Sewage lagoon	<input type="checkbox"/> Insecticide storage	
<input type="checkbox"/> Lateral lines	<input type="checkbox"/> Feedyard	<input type="checkbox"/> Abandoned water well	Direction from well? _____
<input type="checkbox"/> Cess pool	<input type="checkbox"/> Livestock pens	<input type="checkbox"/> Oil well/Gas well	How many feet? _____

FROM	TO	PLUGGING MATERIALS	FROM	TO	PLUGGING MATERIALS
0	1	Asphalt			* Per Pam Chaffee's approval, the well casing, vault and pad were left in place.
1	3	Native soil			
3	72.30	Bentonite grout			

7 CONTRACTOR'S OR LANDOWNER'S CERTIFICATION: This water well was plugged under my jurisdiction and was completed on (mo/day/year) 4-25-16 and this record is true to the best of my knowledge and belief. Kansas Water Well Contractor's License No. 735. This Water Well Record was completed on (mo/day/year) 6-17-16 under the business name of MILCO Environmental Services, Inc. by (signature) *Anthony J. Heath*

Send one white copy to Kansas Department of Health & Environment, Geology Section, 1000 SW Jackson Street, Ste. 420, Topeka, KS 66612-1367. Send one copy to WATER WELL OWNER and retain one for your records.
 Visit us at <http://www.kdheks.gov/waterwell/index.html> Telephone 785-296-5524.



Photos: Plugged SVE-6 – well casing and vault left in place. Gramms 66 site in Quinter, Kansas
MILCO Project No. M269-P1-01

MILCO
Environmental Services, Inc.
320 W. 4th Street
Colby, KS 67701
Tel: 785-460-1956
Fax: 785-460-4220



MILCO

Environmental Services, Inc.

June 21, 2016

320 West 4th Street
Colby, KS 67701
Tel: 785-460-1956
Fax: 785-460-4220
www.milcoinc.com

Kansas Department of Health and Environment
Bureau of Water - GWTS
1000 SW Jackson St, Ste 420
Topeka, KS 66612-1367

RE:

One Stop/Agro Petro/Travel Shoppe #3 - Oakley, Kansas
KDHE Project Code U6-055-295/A6-055-40009/U6-055-11737
MILCO Project No. M250-P1-01

Graham's 66 Service - Quinter, Kansas
KDHE Project Code: U6-032-00513
MILCO Project No. M269-P1-01

Holiday 66/I-C 66
KDHE Project Codes U6-026-00663/U6-026-14849
MILCO Project No. M273-P8-01

Dear Sir or Madam:


Please find enclosed one (1) Water Well Plugging Record for the One Stop/Agro Petro/Travel Shoppe #3 site in Oakley. The well was abandoned by MILCO on May 20, 2016.

Please find enclosed fourteen (14) Water Well Plugging Records for the Holiday 66 site in Hays. The wells were abandoned by MILCO on June 1, 2016.

Please find enclosed twenty-five (25) Water Well Plugging Records for the Grahams 66 site in Quinter. The wells were abandoned by MILCO on April 25 and June 3, 2016.

If you need any additional information, please don't hesitate to contact us.

Respectfully submitted,
MILCO Environmental Services, Inc.

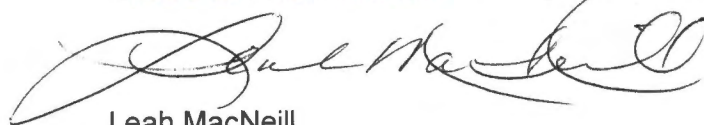

Leah MacNeill

Enclosures

RECEIVED
JUN 23 2016
BUREAU OF WATER