


1 LOCATION OF WATER WELL: Fraction SE 1/4 NW 1/4 SE 1/4 Section Number 7 Township, Number T 11 S Range Number R 27 EW
 County: Gove

Distance and direction from nearest town or city street address of well, if located within city?
SE corner of Hwy 40 & main st., Park, KS

2 WATER WELL OWNER: Terryl Cox
 RR#, St. Address, Box #: Rt 1 Box 64
 City, State, ZIP Code: Park KS 67751
 Board of Agriculture, Division of Water Resources
 Application Number: 2741-79

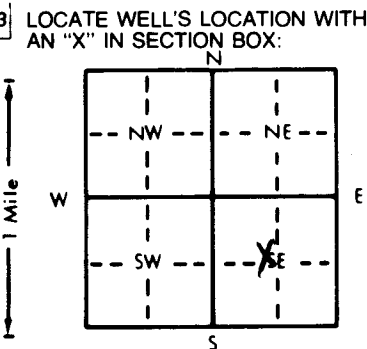

4 DEPTH OF COMPLETED WELL: ~~116~~ 116 ft. ELEVATION: 2741.79
 Depth(s) Groundwater Encountered 1. 105 ft. 2. _____ ft. 3. _____ ft.
 WELL'S STATIC WATER LEVEL: 101.32 ft. below land surface measured on mo/day/yr 3-28-96
 Pump test data: Well water was _____ ft. after _____ hours pumping _____ gpm
 Est. Yield _____ gpm Well water was _____ ft. after _____ hours pumping _____ gpm
 Bore Hole Diameter: 12 in. to _____ ft., and _____ in. to _____ ft.
 WELL WATER TO BE USED AS:
 5 Public water supply 8 Air conditioning 11 Injection well
 1 Domestic 3 Feedlot 6 Oil field water supply 9 Dewatering 12 Other (Specify below)
 2 Irrigation 4 Industrial 7 Lawn and garden only 10 Monitoring well
 Was a chemical/bacteriological sample submitted to Department? Yes _____ No X; If yes, mo/day/yr sample was submitted _____
 Water Well Disinfected? Yes _____ No X

5 TYPE OF BLANK CASING USED:
 1 Steel PVC 3 RMP (SR) 4 ABS 5 Wrought iron 6 Asbestos-Cement 7 Fiberglass 8 Concrete tile 9 Other (specify below) CASING JOINTS: Glued _____ Clamped _____
 Blank casing diameter 4 in. to _____ ft., Dia _____ in. to _____ ft., Dia _____ in. to _____ ft. Welded _____
 Casing height above land surface: Flush in., weight 75.2 lbs./ft. Wall thickness or gauge No. Sch 40 Threaded Flush
 TYPE OF SCREEN OR PERFORATION MATERIAL:
 1 Steel 2 Brass 3 Stainless steel 4 Galvanized steel 5 Fiberglass 6 Concrete tile 7 PVC 8 RMP (SR) 9 ABS 10 Asbestos-cement 11 Other (specify) 12 None used (open hole)
 SCREEN OR PERFORATION OPENINGS ARE:
 1 Continuous slot 2 Louvered shutter 3 Mill slot 4 Key punched 5 Gauzed wrapped 6 Wire wrapped 7 Torch cut 8 Saw cut 9 Drilled holes 10 Other (specify) 11 None (open hole)
 SCREEN-PERFORATED INTERVALS: From 96 ft. to 116 ft. From _____ ft. to _____ ft. From _____ ft. to _____ ft.
 GRAVEL PACK INTERVALS: From 93.5 ft. to 116 ft. From _____ ft. to _____ ft. From _____ ft. to _____ ft.

6 GROUT MATERIAL: 1 Neat cement 2 Cement grout 3 Bentonite 4 Other
 Grout Intervals: From 93.5 ft. to 89.5 ft. From 89.5 ft. to 1 ft. From _____ ft. to _____ ft.
 What is the nearest source of possible contamination:
 1 Septic tank 2 Sewer lines 3 Watertight sewer lines 4 Lateral lines 5 Cess pool 6 Seepage pit 7 Pit privy 8 Sewage lagoon 9 Feedyard 10 Livestock pens 11 Fuel storage 12 Fertilizer storage 13 Insecticide storage 14 Abandoned water well 15 Oil well/Gas well 16 Other (specify below)

Direction from well? _____ How many feet? _____

FROM	TO	LITHOLOGIC LOG	FROM	TO	PLUGGING INTERVALS
0	7	Clayey silt			
7	39.5	lean clay			
39.5	47.5	Sand			
47.5	77.5	Clayey sand			
77.5	81.5	Sand			
81.5	100.0	Clayey sand			
100.0	107	Sand			
107	113	Clayey sand			
113	116	Sand			

7 CONTRACTOR'S OR LANDOWNER'S CERTIFICATION: This water well was (1) constructed, (2) reconstructed, or (3) plugged under my jurisdiction and was completed on (mo/day/year) 4-16-96 and this record is true to the best of my knowledge and belief. Kansas Water Well Contractor's License No. 531 This Water Well Record was completed on (mo/day/yr) 5-15-96 under the business name of GSI by (signature) Allison J. [Signature]

OFFICE USE ONLY
T
R
EW
SEC.
1/4
1/4
1/4