


1 LOCATION OF WATER WELL: County: Gove Fraction: SW 1/4 NE 1/4 SW 1/4 Section Number: 7 Township Number: T 11 S Range Number: R 27 EW

Distance and direction from nearest town or city street address of well if located within city?
NW of Cedar st & Union Pacific RR, Park, KS

2 WATER WELL OWNER: RR#, St. Address, Box #: 208E Forbes Field, Bldg 740 City, State, ZIP Code: Topeka KS 66620-0001 Board of Agriculture, Division of Water Resources Application Number:

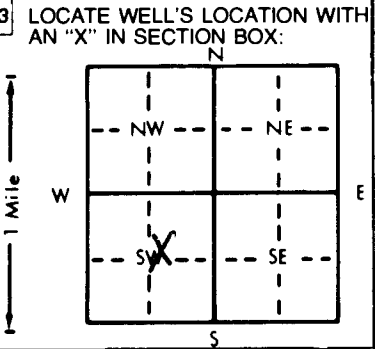

4 DEPTH OF COMPLETED WELL: 149 ft. ELEVATION: 774.96
 Depth(s) Groundwater Encountered: 1. 105 ft. 2. 277.96 ft. 3. ft.
 WELL'S STATIC WATER LEVEL: 102.84 ft. below land surface measured on mo/day/yr 3-27-96
 Pump test data: Well water was ft. after hours pumping gpm
 Est. Yield gpm: Well water was ft. after hours pumping gpm
 Bore Hole Diameter: 12 in. to ft., and in. to ft.
 WELL WATER TO BE USED AS:
 5 Public water supply 8 Air conditioning 11 Injection well
 1 Domestic 3 Feedlot 6 Oil field water supply 9 Dewatering 12 Other (Specify below)
 2 Irrigation 4 Industrial 7 Lawn and garden only 10 Monitoring well
 Was a chemical/bacteriological sample submitted to Department? Yes No No X; If yes, mo/day/yr sample was submitted
 Water Well Disinfected? Yes No No X

5 TYPE OF BLANK CASING USED:
 1 Steel 3 RMP (SR) 5 Wrought iron 8 Concrete tile CASING JOINTS: Glued Clamped
2 PVC 4 ABS 7 Fiberglass Threaded Flush
 Blank casing diameter 4 in. to ft. Dia. in. to ft. Dia. in. to ft.
 Casing height above land surface: Flush in., weight 2 lbs./ft. Wall thickness or gauge No. Sch 40
 TYPE OF SCREEN OR PERFORATION MATERIAL:
 1 Steel 3 Stainless steel 5 Fiberglass PVC 10 Asbestos-cement
 2 Brass 4 Galvanized steel 6 Concrete tile 8 RMP (SR) 11 Other (specify) ft.
 9 ABS 12 None used (open hole)
 SCREEN OR PERFORATION OPENINGS ARE:
 1 Continuous slot 3 Mill slot 5 Gauzed wrapped 8 Saw cut 11 None (open hole)
 2 Louvered shutter 4 Key punched 6 Wire wrapped 9 Drilled holes
 SCREEN-PERFORATED INTERVALS: From 138.5 ft. to 148.5 ft. From ft. to ft.
 GRAVEL PACK INTERVALS: From 134 ft. to 149 ft. From ft. to ft.

6 GROUT MATERIAL: 1 Neat cement 2 Cement grout 3 Bentonite 4 Other
 Grout Intervals: From 2 ft. to 130 ft. From 130 ft. to 134 ft. From ft. to ft.
 What is the nearest source of possible contamination:
 1 Septic tank 4 Lateral lines 7 Pit privy 10 Livestock pens 14 Abandoned water well
 2 Sewer lines 5 Cess pool 8 Sewage lagoon 11 Fuel storage 15 Oil well/Gas well
 3 Watertight sewer lines 6 Seepage pit 9 Feedyard 12 Fertilizer storage 16 Other (specify below)
 13 Insecticide storage

Direction from well? _____ How many feet? _____

FROM	TO	LITHOLOGIC LOG	FROM	TO	PLUGGING INTERVALS
0	4	Clay			
4	9	Silt			
9	23	Silty clay			
23	36	Clay			
36	41	Silt			
41	42	Caliche			
42	44	Clayey sand			
44	54	Sand			
54	76	Silty sand			
76	85	Clayey sand & gravel			
85	99	Sand			
99	150	Clayey sand			

7 CONTRACTOR'S OR LANDOWNER'S CERTIFICATION: This water well was (1) constructed, (2) reconstructed, or (3) plugged under my jurisdiction and was completed on (mo/day/year) 4-16-96 and this record is true to the best of my knowledge and belief. Kansas Water Well Contractor's License No. 531 This Water Well Record was completed on (mo/day/yr) 5-15-96 under the business name of GSI by (signature) Alison Swin

OFFICE USE ONLY T R EW SEC. 1/4 1/4 1/4