


1 LOCATION OF WATER WELL: Fraction SE 1/4 NW 1/4 NE 1/4 Section Number 6 Township Number T 11 S Range Number R 27 E (N)
 County: Douglas

Distance and direction from nearest town or city street address of well if located within city?
1 N of Park Ks

2 WATER WELL OWNER: Bill McGulley
 RR#, St. Address, Box #: Park, Ks
 City, State, ZIP Code: _____
 Board of Agriculture, Division of Water Resources
 Application Number: _____

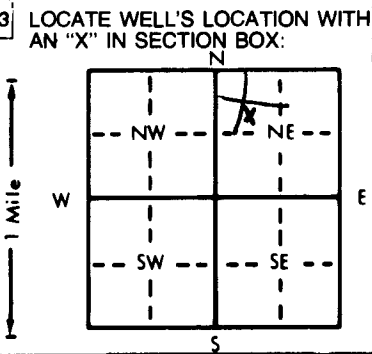

4 DEPTH OF COMPLETED WELL: 60 ft. ELEVATION: _____
 Depth(s) Groundwater Encountered 1. 50 ft. 2. _____ ft. 3. _____ ft.
 WELL'S STATIC WATER LEVEL 50 ft. below land surface measured on mo/day/yr _____
 Pump test data: Well water was _____ ft. after _____ hours pumping _____ gpm
 Est. Yield _____ gpm: Well water was _____ ft. after _____ hours pumping _____ gpm
 Bore Hole Diameter _____ in. to _____ ft., and _____ in. to _____ ft.
 WELL WATER TO BE USED AS:
 5 Public water supply 8 Air conditioning 11 Injection well
 1 Domestic 3 Feedlot 6 Oil field water supply 9 Dewatering 12 Other (Specify below)
 2 Irrigation 4 Industrial 7 Lawn and garden only 10 Observation well stock
 Was a chemical/bacteriological sample submitted to Department? Yes _____ No _____; If yes, mo/day/yr sample was submitted _____
 Water Well Disinfected? Yes _____ No _____

5 TYPE OF BLANK CASING USED:
 Steel 3 RMP (SR) 5 Wrought iron 8 Concrete tile CASING JOINTS: Glued _____ Clamped _____
 PVC 4 ABS 6 Asbestos-Cement 9 Other (specify below) Welded _____
 Fiberglass 7 Fiberglass _____ Threaded _____
 Blank casing diameter 5 in. to 60 ft., Dia _____ in. to _____ ft., Dia _____ in. to _____ ft.
 Casing height above land surface 12 in., weight _____ lbs./ft. Wall thickness or gauge No. _____
 TYPE OF SCREEN OR PERFORATION MATERIAL:
 Steel 3 Stainless steel 5 Fiberglass 7 PVC 10 Asbestos-cement
 Brass 4 Galvanized steel 6 Concrete tile 8 RMP (SR) 11 Other (specify) _____
 None used (open hole)
 SCREEN OR PERFORATION OPENINGS ARE:
 Continuous slot 3 Mill slot 5 Gauzed wrapped 8 Saw cut 11 None (open hole)
 Louvered shutter 4 Key punched 6 Wire wrapped 9 Drilled holes
 Torch cut 10 Other (specify) _____
 SCREEN-PERFORATED INTERVALS: From Unknown ft. to _____ ft., From _____ ft. to _____ ft.
 From _____ ft. to _____ ft., From _____ ft. to _____ ft.
 GRAVEL PACK INTERVALS: From _____ ft. to _____ ft., From _____ ft. to _____ ft.
 From _____ ft. to _____ ft., From _____ ft. to _____ ft.

6 GROUT MATERIAL: 1 Neat cement 2 Cement grout 3 Bentonite 4 Other _____
 Grout Intervals: From Unknown ft. to _____ ft., From _____ ft. to _____ ft., From _____ ft. to _____ ft.
 What is the nearest source of possible contamination:
 1 Septic tank 4 Lateral lines 7 Pit privy 10 Livestock pens 14 Abandoned water well
 2 Sewer lines 5 Cess pool 8 Sewage lagoon 11 Fuel storage 15 Oil well/Gas well
 3 Watertight sewer lines 6 Seepage pit 9 Feedyard 12 Fertilizer storage 16 Other (specify below)
 13 Insecticide storage Drow
 Direction from well? North How many feet? 1000

FROM	TO	LITHOLOGIC LOG	FROM	TO	LITHOLOGIC LOG
		<u>Plugging cut.</u>			
<u>60</u>	<u>40</u>	<u>Sand</u>			
<u>40</u>	<u>20</u>	<u>Clay</u>			
<u>20</u>	<u>5</u>	<u>Cement</u>			
<u>0</u>	<u>5</u>	<u>Top soil</u>			

7 CONTRACTOR'S OR LANDOWNER'S CERTIFICATION: This water well was (1) constructed, (2) reconstructed, or (3) plugged under my jurisdiction and was completed on (mo/day/year) 10-16-87 and this record is true to the best of my knowledge and belief. Kansas Water Well Contractor's License No. 376 This Water Well Record was completed on (mo/day/yr) 10-16-87 under the business name of B+B Oulley by (signature) Joseph Beckman

OFFICE USE ONLY
T
R
EW
SEC.