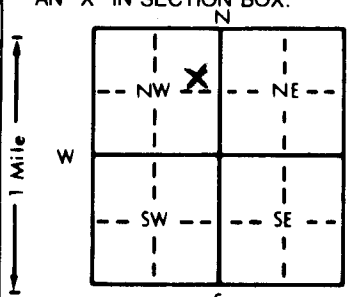


1 LOCATION OF WATER WELL: County: Cove Fraction: SE 1/4 NE 1/4 NW 1/4 Section Number: 10 Township Number: T 11 S Range Number: R 27 E

Distance and direction from nearest town or city street address of well if located within city?
2 1/2 east 1 1/2 north & 1/2 east of Park, Ks.

2 WATER WELL OWNER: Leo A. Ochs
 RR#, St. Address, Box #: RT, 3 Box 24E
 City, State, ZIP Code: Quinter, Ks. 67752
 Board of Agriculture, Division of Water Resources
 Application Number: 20,030

3 LOCATE WELL'S LOCATION WITH AN "X" IN SECTION BOX:

 4 DEPTH OF COMPLETED WELL: 206 ft. ELEVATION:
 Depth(s) Groundwater Encountered 1. ft. 2. ft. 3. ft.
 WELL'S STATIC WATER LEVEL 76 ft. below land surface measured on mo/day/yr
 Pump test data: Well water was ft. after hours pumping gpm
 Est. Yield gpm: Well water was ft. after hours pumping gpm
 Bore Hole Diameter: 28 in. to 206 ft. and in. to ft.
 WELL WATER TO BE USED AS: 5 Public water supply 8 Air conditioning 11 Injection well
 1 Domestic 3 Feedlot 6 Oil field water supply 9 Dewatering 12 Other (Specify below)
 2 Irrigation 4 Industrial 7 Lawn and garden only 10 Monitoring well
 Was a chemical/bacteriological sample submitted to Department? Yes.....No x.....; If yes, mo/day/yr sample was submitted
 Water Well Disinfected? Yes No x

5 TYPE OF BLANK CASING USED:
 1 Steel 3 RMP (SR) 5 Wrought iron 8 Concrete tile
 2 PVC 4 ABS 6 Asbestos-Cement 9 Other (specify below)
 7 Fiberglass
 CASING JOINTS: Glued X Clamped
 Welded
 Threaded
 Blank casing diameter 16 in. to 106 ft., Dia in. to ft., Dia in. to ft.
 Casing height above land surface 24 in., weight 16.4 lbs./ft. Wall thickness or gauge No. 500
 TYPE OF SCREEN OR PERFORATION MATERIAL:
 1 Steel 3 Stainless steel 5 Fiberglass 8 RMP (SR) 10 Asbestos-cement
 2 Brass 4 Galvanized steel 6 Concrete tile 9 ABS 11 Other (specify)
 12 None used (open hole)
 SCREEN OR PERFORATION OPENINGS ARE:
 1 Continuous slot 3 Mill slot 5 Gauzed wrapped 8 Saw cut 11 None (open hole)
 2 Louvered shutter 4 Key punched 6 Wire wrapped 9 Drilled holes
 7 Torch cut 10 Other (specify)
 SCREEN-PERFORATED INTERVALS: From 106 ft. to 206 ft., From ft. to ft.
 From ft. to ft., From ft. to ft.
 GRAVEL PACK INTERVALS: From 20 ft. to 206 ft., From ft. to ft.
 From ft. to ft., From ft. to ft.

6 GROUT MATERIAL: 1 Neat cement 2 Cement grout 3 Bentonite 4 Other
 Grout Intervals: From 0 ft. to 20 ft., From ft. to ft., From ft. to ft.
 What is the nearest source of possible contamination:
 1 Septic tank 4 Lateral lines 7 Pit privy 10 Livestock pens 14 Abandoned water well
 2 Sewer lines 5 Cess pool 8 Sewage lagoon 11 Fuel storage 15 Oil well/Gas well
 3 Watertight sewer lines 6 Seepage pit 9 Feedyard 12 Fertilizer storage 16 Other (specify below)
 13 Insecticide storage
 Direction from well? West How many feet? 50

| FROM | TO | LITHOLOGIC LOG | FROM | TO | PLUGGING INTERVALS |
|------|----|--------------------------|------|-----|---------------------------------|
| 0 | 3 | Top soil | 88 | 92 | Med. sand with clay streaks |
| 3 | 10 | Clay | 92 | 94 | Med. hard |
| 10 | 23 | Caliche (med. hard) | 94 | 110 | Med. sand & gravel |
| 23 | 24 | Cemented sand | 110 | 112 | Clay |
| 24 | 28 | Med. sand | 112 | 124 | Med. sand 7 gravel |
| 28 | 39 | Clay with caliche streak | 124 | 125 | Hard white rock |
| 39 | 41 | Clay | 125 | 150 | Med. sand & gravel |
| 41 | 47 | Sand & gravel (large) | 150 | 178 | Med. hard streaks & med. sand |
| 47 | 55 | Sand with clay streaks | 178 | 195 | Rocky ledges, med sand & gravel |
| 55 | 64 | Clay & caliche | 195 | 199 | Rocky with med. sand |
| 64 | 69 | Med. sand | 199 | 206 | Ochre with rock |
| 69 | 71 | Caliche (hard) | | | |
| 71 | 73 | Clay | | | |
| 73 | 87 | Fine to med. sand | | | |
| 87 | 88 | Hard streaks | | | |

7 CONTRACTOR'S OR LANDOWNER'S CERTIFICATION: This water well was (1) constructed, (2) reconstructed, or (3) plugged under my jurisdiction and was completed on (mo/day/year) 5-1-91 and this record is true to the best of my knowledge and belief. Kansas Water Well Contractor's License No. 394 This Water Well Record was completed on (mo/day/yr) 5-6-91
 under the business name of Woofter Pump & Well by (signature) Walter Woofter

INSTRUCTIONS: Use typewriter or ball point pen. PLEASE PRESS FIRMLY and PRINT clearly. Please fill in blanks, underline or circle the correct answers. Send top three copies to Kansas Department of Health and Environment, Bureau of Water, Topeka, Kansas 66620-7320. Telephone: 913-296-5545. Send one to WATER WELL OWNER and retain one for your records.

OFFICE USE ONLY
T
R
EW
SEC.
1/4
1/4
1/4