


WATER WELL PLUGGING RECORD Form WWC-5P KSA 82a-1212 ID NO.

1 LOCATION OF WATER WELL: County: GOVE Fraction SW 1/4 NW 1/4 SE 1/4 Section Number 7 Township Number 11 S Range Number 27 EW

Distance and direction from nearest town or city street address of well if located within city? SE CORNER OF HWY 40 & MAIN STREET, PARK, KS

2 WATER WELL OWNER: TERRY COX RR#, St. Address, Box #: RT. 1 BOX 64 City, State ZIP Code: PARK, KS 67751 Global Positioning Systems (decimal degrees, min. of 4 digits)

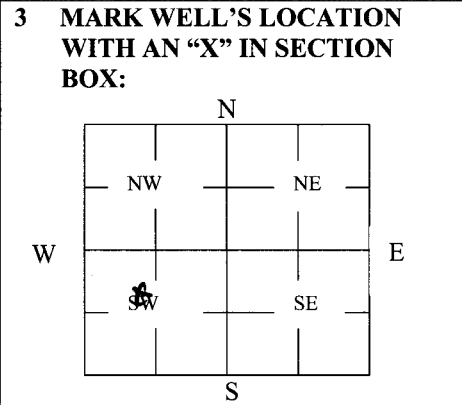

4 DEPTH OF WELL 69.7 ft. WELL'S STATIC WATER LEVEL 62.4 ft. WELL WAS USED AS: 1 Domestic, 2 Irrigation, 3 Feedlot, 4 Industrial, 5 Public Water Supply, 6 Oil Field Water Supply, 7 Domestic (Lawn & Garden), 8 Air Conditioning, 9 Dewatering, 10 Monitoring, 11 Injection Well, 12 Other. Was a chemical/bacteriological sample submitted to Department? Yes No X

5 TYPE OF BLANK CASING USED: 1 Steel, 2 PVC, 3 RMP (SR), 4 ABS, 5 Wrought, 6 Asbestos-Cement, 7 Fiberglass, 8 Concrete Tile, 9 Other (Specify below). Blank casing diameter 4" in. Was casing pulled? Yes X No. If yes, how much 3' Casing height above or below land surface in.

6 GROUT PLUG MATERIAL: 1 Neat cement, 2 Cement grout, 3 Bentonite, 4 Other. Grout Plug Intervals: From 3' ft. to 69.7 ft., From ft. to ft., From to ft. What is the nearest source of possible contamination: 1 Septic tank, 2 Sewer lines, 3 Watertight sewer lines, 4 Lateral lines, 5 Cess pool, 6 Seepage pit, 7 Pit privy, 8 Sewage lagoon, 9 Feedyard, 10 Livestock pens, 11 Fuel Storage, 12 Fertilizer storage, 13 Insecticide storage, 14 Abandoned water well, 15 Oil well/Gas well, 16 Other (specify below). Direction from well? How many feet?

Table with columns: FROM, TO, PLUGGING MATERIALS. Row 1: 0, 3', NATIVE MATERIAL. Row 2: 3', 69.7, BENTONITE CHIPS.

7 CONTRACTOR'S OR LANDOWNER'S CERTIFICATION: This water well was plugged under my jurisdiction and was completed on (mo/day/year) 2/1/09 and this record is true to the best of my knowledge and belief. Kansas Water Well Contractor's License No. NA. This Water Well Record was completed on (mo/day/year) 2/16/09 under the business name of ENVIRONMENTAL REMEDIATION by (signature)

INSTRUCTIONS: Use typewriter or ballpoint pen. Please press firmly and print clearly. Please fill in blanks, underline or circle the correct answers. Send top three copies to Kansas Department of Health and Environment, Bureau of Water, Geology Section, 1000 SW Jackson St., Ste. 420, Topeka, Kansas 66612-1367. Telephone: 785/296-5522. Send one to Water Well Owner and retain one for your records. Visit us at http://www.kdheks.gov/geo/waterwells.