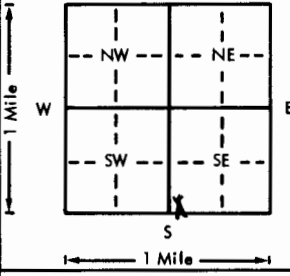
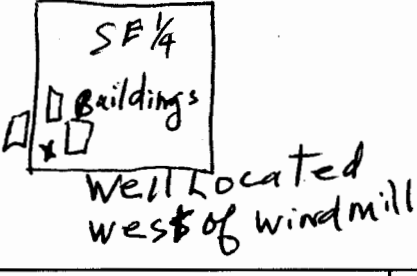


USE TYPEWRITER OR BALL POINT PEN-PRESS FIRMLY, PRINT CLEARLY.

WATER WELL RECORD  
KSA 82a-1201-1215

Kansas Department of Health and Environment-Division of Environment  
(Water well Contractors)  
Topeka, Kansas 66620

1. Location of well: County <b>Gove</b>		Fraction <b>SW 1/4 SW 1/4 SE 1/4</b>		Section number <b>12</b>		Township number <b>T 11 S</b>		Range number <b>R 27</b>		<b>DR L</b> <b>E/W</b>	
2. Distance and direction from nearest town or city: <b>2 1/2 - 1 1/2 W of Quinter</b>				3. Owner of well: <b>Albert Zerr</b> R.R. or street: <b>Rt. 4</b> City, state, zip code: <b>Quinter, Kansas 67752</b>							
4. Locate with "X" in section below: 				Sketch map: 				6. Bore hole dia. <b>5</b> in. Completion date <b>8-16-76</b> Well depth <b>230</b> ft.			
				7. <input checked="" type="checkbox"/> Cable tool <input checked="" type="checkbox"/> Rotary <input type="checkbox"/> Driven <input type="checkbox"/> Dug <input type="checkbox"/> Hollow rod <input type="checkbox"/> Jetted <input type="checkbox"/> Bored <input type="checkbox"/> Reverse rotary				8. Use: <input checked="" type="checkbox"/> Domestic <input type="checkbox"/> Public supply <input type="checkbox"/> Industry <input type="checkbox"/> Irrigation <input type="checkbox"/> Air conditioning <input type="checkbox"/> Stock <input type="checkbox"/> Lawn <input type="checkbox"/> Oil field water <input type="checkbox"/> Other			
				9. Casing: Material <b>plastic</b> Height: <b>above</b> or below Threaded <input type="checkbox"/> Welded <input checked="" type="checkbox"/> Surface <b>18</b> in. RMP <input type="checkbox"/> PVC <input checked="" type="checkbox"/> Weight _____ lbs./ft. Dia. <b>5</b> in. to <b>230</b> ft. depth Wall thickness: inches or Dia. _____ in. to _____ ft. depth gage No. _____				10. Screen: Manufacturer's name <b>Peerless</b> <b>Plastics Pipe</b> Type <b>PVC</b> Dia. <b>5 in.</b> Slot/gauze _____ Length <b>20 ft</b> Set between _____ ft. and _____ ft. Gravel pack? <b>yes</b> Size range of material <b>1/4 down</b>			
5. Type and color of material				From		To		11. Static water level: _____ mo./day/yr. <b>155</b> ft. below land surface Date <b>8-16-76</b>			
<b>silt + clay</b>				<b>0</b>		<b>80</b>		12. Pumping level below land surfaces: <b>118</b> ft. after <b>6</b> hrs. pumping _____ g.p.m. <b>118</b> ft. after _____ hrs. pumping _____ g.p.m. Estimated maximum yield <b>100</b> g.p.m.			
<b>sand-sandstone + clay</b>				<b>80</b>		<b>118</b>		13. Water sample submitted: _____ mo./day/yr. Yes <input type="checkbox"/> No <input checked="" type="checkbox"/> Date _____			
<b>Rock + gravel</b>				<b>118</b>		<b>135</b>		14. Well head completion: <input type="checkbox"/> Pitless adapter _____ inches above grade			
<b>sand + gravel</b>				<b>135</b>		<b>210</b>		<input checked="" type="checkbox"/> Well grouted? <b>X</b> With: <b>clay</b> cement <input type="checkbox"/> Bentonite <input type="checkbox"/> Concrete Depth: From <b>0</b> ft. to <b>20</b> ft.			
<b>gravel + clay</b>				<b>210</b>		<b>230</b>		15. Nearest source of possible contamination: ft. _____ Direction _____ Type _____ Well disinfected upon completion? _____ Yes _____ No			
<b>shale</b>				<b>230</b>				17. Pump: <input checked="" type="checkbox"/> Not installed Manufacturer's name _____ Model number _____ HP _____ Volts _____ Length of drop pipe _____ ft. capacity _____ g.p.m. Type: <input type="checkbox"/> Submersible <input type="checkbox"/> Turbine <input type="checkbox"/> Jet <input type="checkbox"/> Reciprocating <input type="checkbox"/> Centrifugal <input type="checkbox"/> Other			
								20. Water well contractor's certification: This well was drilled under my jurisdiction and this report is true to the best of my knowledge and belief. <b>Aqua Well Drilling</b> <b>281</b> Business name _____ License No. _____ Address <b>Gove, Kansas 67736</b> Signed <b>J. M. Juttie</b> Date <b>6-20-77</b> Authorized representative _____			
18. Elevation:		19. Remarks: <b>static level 87 ft</b> <b>when irrigation wells are not pumping 155 ft when the drigh well is pumping 100 ft south</b>									
Topography: <input type="checkbox"/> Hill <input type="checkbox"/> Slope <input checked="" type="checkbox"/> Upland <input type="checkbox"/> Valley											

Forward the white, blue and pink copies to the Department of Health and Environment

Form WWC-5