


1 LOCATION OF WATER WELL: Fraction NE 1/4 NE 1/4 SW 1/4 Section Number 7 Township Number T 11 S Range Number R 27 EW

Distance and direction from nearest town or city street address of well if located within city?
 SW corner of Elm St. & Alley located between 4th & 5th streets

2 WATER WELL OWNER: Kenneth Cooksey
 RR#, St. Address, Box #: 419 main
 City, State, ZIP Code: Quinter KS 67752
 Board of Agriculture, Division of Water Resources
 Application Number: 2744.19

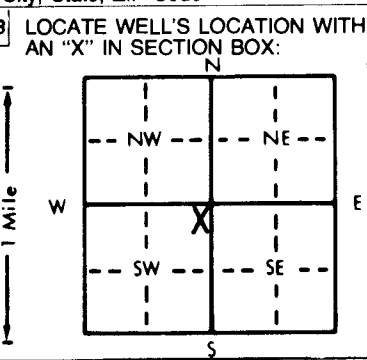

4 DEPTH OF COMPLETED WELL: 116 ft. ELEVATION: 2744.19
 Depth(s) Groundwater Encountered 1. 107.5 ft. 2. ft. 3. ft.
 WELL'S STATIC WATER LEVEL 104.92 ft. below land surface measured on mo/day/yr 3-26-96
 Pump test data: Well water was ft. after hours pumping gpm
 Est. Yield gpm: Well water was ft. after hours pumping gpm
 Bore Hole Diameter 12 in. to ft. and in. to ft.
 WELL WATER TO BE USED AS:
 1 Domestic 2 Irrigation 3 Feedlot 4 Industrial 5 Public water supply 6 Oil field water supply 7 Lawn and garden only 8 Air conditioning 9 Dewatering 10 Monitoring well 11 Injection well 12 Other (Specify below)
 Was a chemical/bacteriological sample submitted to Department? Yes No X If yes, mo/day/yr sample was submitted Water Well Disinfected? Yes No X

5 TYPE OF BLANK CASING USED:
 1 Steel 2 PVC 3 RMP (SR) 4 ABS 5 Wrought iron 6 Asbestos-Cement 7 Fiberglass 8 Concrete tile 9 Other (specify below) CASING JOINTS: Glued Clamped Welded Threaded Flush
 Blank casing diameter 4 in. to ft. Dia in. to ft. Dia in. to ft. Dia in. to ft.
 Casing height above land surface Flush in. weight 105.2 lbs./ft. Wall thickness or gauge No. Sch 40
 TYPE OF SCREEN OR PERFORATION MATERIAL:
 1 Steel 2 Brass 3 Stainless steel 4 Galvanized steel 5 Fiberglass 6 Concrete tile 7 PVC 8 RMP (SR) 9 ABS 10 Asbestos-cement 11 Other (specify) 12 None used (open hole)
 SCREEN OR PERFORATION OPENINGS ARE:
 1 Continuous slot 2 Louvered shutter 3 Mill slot 4 Key punched 5 Gauzed wrapped 6 Wire wrapped 7 Torch cut 8 Saw cut 9 Drilled holes 10 Other (specify) 11 None (open hole)
 SCREEN-PERFORATED INTERVALS: From 96 ft. to 116 ft. From ft. to ft. From ft. to ft. From ft. to ft.
 GRAVEL PACK INTERVALS: From 94 ft. to 116 ft. From ft. to ft. From ft. to ft. From ft. to ft.

6 GROUT MATERIAL: 1 Neat cement 2 Cement grout 3 Bentonite 4 Other
 Grout intervals: From 2 ft. to 94 ft. From ft. to ft. From ft. to ft. From ft. to ft.
 What is the nearest source of possible contamination:
 1 Septic tank 2 Sewer lines 3 Watertight sewer lines 4 Lateral lines 5 Cess pool 6 Seepage pit 7 Pit privy 8 Sewage lagoon 9 Feedyard 10 Livestock pens 11 Fuel storage 12 Fertilizer storage 13 Insecticide storage 14 Abandoned water well 15 Oil well/Gas well 16 Other (specify below)

Direction from well? How many feet?

FROM	TO	LITHOLOGIC LOG	FROM	TO	PLUGGING INTERVALS
0	39.5	Lean Clay			
39.5	40	Sand			
40	50	Lean Clay			
50	61	Clayey Sand			
61	79	Sand			
79	100	Clayey sand			
100	107	Sand			
107	109	Clayey sand			
109	116	Sand			

7 CONTRACTOR'S OR LANDOWNER'S CERTIFICATION: This water well was (1) constructed (2) reconstructed, or (3) plugged under my jurisdiction and was completed on (mo/day/year) 4-16-96 and this record is true to the best of my knowledge and belief. Kansas Water Well Contractor's License No. 531 This Water Well Record was completed on (mo/day/yr) 5-15-96 under the business name of GSI by (signature) Allison Swin

OFFICE USE ONLY T R EW SEC. 1/4 1/4 1/4