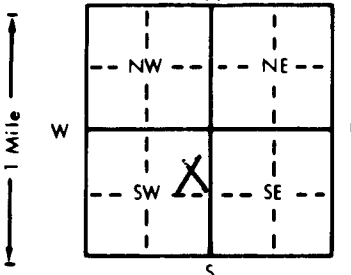


1 LOCATION OF WATER WELL: County: Gove Fraction: SE 1/4 NE 1/4 SW 1/4 Section Number: 7 Township Number: T 11 S Range Number: R 27 E/W

Distance and direction from nearest town or city street address of well if located within city?

2 WATER WELL OWNER: Mardan Motors RR#, St. Address, Box #: Park, KS 67751 City, State, ZIP Code: MW#10 Board of Agriculture, Division of Water Resources Application Number:







WELL WATER TO BE USED AS:

5 Public water supply	8 Air conditioning	11 Injection well
1 Domestic	3 Feedlot	6 Oil field water supply
2 Irrigation	4 Industrial	7 Lawn and garden only
		10 <u>Monitoring well</u>

Was a chemical/bacteriological sample submitted to Department? Yes X No X; If yes, mo/day/yr sample was submitted

Water Well Disinfected? Yes X No X

5 TYPE OF BLANK CASING USED:

1 Steel	3 RMP (SR)	6 Asbestos-Cement	9 Other (specify below)
2 PVC	4 ABS	7 Fiberglass	

CASING JOINTS: Glued X Clamped X Welded X Threaded X



TYPE OF SCREEN OR PERFORATION MATERIAL:

1 Steel	3 Stainless steel	5 Fiberglass	8 RMP (SR)	10 Asbestos-cement
2 Brass	4 Galvanized steel	6 Concrete tile	9 ABS	11 Other (specify)
				12 None used (open hole)

SCREEN OR PERFORATION OPENINGS ARE:

1 Continuous slot	3 Mill slot	5 Gauzed wrapped	8 Saw cut	11 None (open hole)
2 Louvered shutter	4 Key punched	6 Wire wrapped	9 Drilled holes	
		7 Torch cut <u>115</u>	10 Other (specify)	

SCREEN-PERFORATED INTERVALS: From 85 ft. to 115 ft., From 85 ft. to 115 ft., From 85 ft. to 115 ft., From 85 ft. to 115 ft.

GRAVEL PACK INTERVALS: From 80 ft. to 115 ft., From 80 ft. to 115 ft., From 80 ft. to 115 ft., From 80 ft. to 115 ft.

6 GROUT MATERIAL: 1 Neat cement 2 Cement grout 3 Bentonite 4 Other

Grout intervals: From 0 ft. to 2 ft., From 2 ft. to 80 ft., From 80 ft. to 80 ft., From 80 ft. to 80 ft.

What is the nearest source of possible contamination:

1 Septic tank	4 Lateral lines	7 Pit privy	10 Livestock pens	14 Abandoned water well
2 Sewer lines	5 Cess pool	8 Sewage lagoon	11 Fuel storage	15 Oil well/Gas well
3 Watertight sewer lines	6 Seepage pit	9 Feedyard	12 Fertilizer storage	16 Other (specify below)
			13 Insecticide storage	<u>Contaminated site</u>

Direction from well? How many feet?

FROM	TO	LITHOLOGIC LOG	FROM	TO	PLUGGING INTERVALS
0	2	Surface			
2	12	Loam			
12	27	Sandy clay & caliche			
27	43	Sand, clay, caliche w/ sand str ks			
43	50	Tight med sand w/clay			
50	59	Sandy clay			
59	60	med sand w/clay			
60	64	Sandy clay w/sand strks			
64	70	Sandy clay			
70	91	med sand w/clay strks			
91	100	Semi-tight med sand w/clay			
100	118	Sandy clay & med sand			

7 CONTRACTOR'S OR LANDOWNER'S CERTIFICATION: This water well was (1) constructed, (2) reconstructed, or (3) plugged under my jurisdiction and was completed on (mo/day/year) 6-2-98 and this record is true to the best of my knowledge and belief. Kansas Water Well Contractor's License No. 354 This Water Well Record was completed on (mo/day/yr) 7-17-98 under the business name of Woofter Pump Well, Inc by (signature) Jay Woofter