


1 LOCATION OF WATER WELL: Fraction NW 1/4 NE 1/4 SW 1/4 Section Number 7- Township Number T 11 S Range Number R 27 EW

Distance and direction from nearest town or city street address of well if located within city?

2 WATER WELL OWNER: Park Oil Co. RR#, St. Address, Box #: Park, Ks. 67751 Board of Agriculture, Division of Water Resources City, State, ZIP Code: MW #2 Application Number:

3 LOCATE WELL'S LOCATION WITH AN "X" IN SECTION BOX:

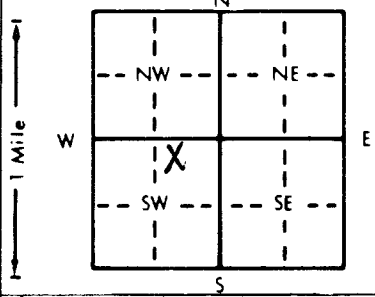

4 DEPTH OF COMPLETED WELL: 125 ft. ELEVATION: WELL'S STATIC WATER LEVEL: 105.39 ft. below land surface measured on mo/day/yr Pump test data: Well water was 8 gpm at 125 ft. after 8 hours pumping. Est. Yield: 8 gpm. Bore Hole Diameter: 8 in. to 125 ft. and 125 in. to ft. WELL WATER TO BE USED AS: 5 Public water supply, 8 Air conditioning, 11 Injection well, 1 Domestic, 3 Feedlot, 6 Oil field water supply, 9 Dewatering, 12 Other (Specify below), 2 Irrigation, 4 Industrial, 7 Lawn and garden only, 10 Monitoring well. Was a chemical/bacteriological sample submitted to Department? Yes No X. If yes, mo/day/yr sample was submitted Water Well Disinfected? Yes No X

5 TYPE OF BLANK CASING USED: 1 Steel, 3 RMP (SR), 2 PVC, 4 ABS. 5 Wrought iron, 6 Asbestos-Cement, 7 Fiberglass. 8 Concrete tile, 9 Other (specify below), 10 Asbestos-cement. CASING JOINTS: Glued, Clamped, Welded, Threaded X

Blank casing diameter: 4 in. to 95 ft. Dia. Casing height above land surface: 0 in. weight: 2.071 lbs./ft. Wall thickness or gauge No. 237

TYPE OF SCREEN OR PERFORATION MATERIAL: 1 Steel, 3 Stainless steel, 2 Brass, 4 Galvanized steel. 5 Fiberglass, 6 Concrete tile. 7 PVC, 8 RMP (SR), 9 ABS, 10 Asbestos-cement, 11 Other (specify), 12 None used (open hole)

SCREEN OR PERFORATION OPENINGS ARE: 1 Continuous slot, 2 Louvered shutter, 3 Mill slot, 4 Key punched, 5 Gauzed wrapped, 6 Wire wrapped, 7 Torch cut, 8 Saw cut, 9 Drilled holes, 10 Other (specify), 11 None (open hole)

SCREEN-PERFORATED INTERVALS: From 95 ft. to 125 ft. GRAVEL PACK INTERVALS: From 91 ft. to 125 ft.

6 GROUT MATERIAL: 1 Neat cement, 2 Cement grout, 3 Bentonite, 4 Other. Grout Intervals: From 0 ft. to 85 ft. From 85 ft. to 91 ft.

What is the nearest source of possible contamination: 1 Septic tank, 2 Sewer lines, 3 Watertight sewer lines, 4 Lateral lines, 5 Cess pool, 6 Seepage pit, 7 Pit privy, 8 Sewage lagoon, 9 Feedyard, 10 Livestock pens, 11 Fuel storage, 12 Fertilizer storage, 13 Insecticide storage, 14 Abandoned water well, 15 Oil well/Gas well, 16 Other (specify below). Removed Fuel Storage

Direction from well? How many feet?

FROM	TO	LITHOLOGIC LOG	FROM	TO	PLUGGING INTERVALS
0	3	Surface			
3	30	Loess			
30	38	Clay w/Caliche Strks.			
38	50	Fine Sand w/Clay Strks.			
50	55	Sandy Clay w/Sand Strks.			
55	65	Fine Sand w/Clay Strks.			
65	79	Sandy Clay w/Sand & Caliche Strks.			
79	90	Sand & Gravel			
90	100	Sand & Gravel w/Clay Strks			
100	110	Sandy Clay			
110	121	Fine to Med. Sand w/Clay Strks.			
121	125	Cemented Sand w/Clay Strks.			

7 CONTRACTOR'S OR LANDOWNER'S CERTIFICATION: This water well was (1) constructed, (2) reconstructed, or (3) plugged under my jurisdiction and was completed on (mo/day/year) 11-30-94 and this record is true to the best of my knowledge and belief. Kansas Water Well Contractor's License No. 554. This Water Well Record was completed on (mo/day/yr) 1-6-95 under the business name of Wooter Pump & Well, Inc. by signature [Signature]

INSTRUCTIONS: Use typewriter or ball point pen. PLEASE PRESS FIRMLY and PRINT clearly. Please fill in blanks, underline or circle the correct answers. Send top three copies to Kansas Department of Health and Environment, Bureau of Water, Topeka, Kansas 66620-0001. Telephone: 913-296-5545. Send one to WATER WELL OWNER and retain one for your records.