


WATER WELL RECORD Form WWC-5 KSA 82a-1212

1 LOCATION OF WATER WELL: Fraction NW 1/4 NE 1/4 SW 1/4 Section Number 7 Township Number T 11 S Range Number R 28 E/W 10  
 County: Gove Distance and direction from nearest town or city street address of well if located within city?

2 WATER WELL OWNER: Verle Cox  
 RR#, St. Address, Box #: P. O. Box 102 Board of Agriculture, Division of Water Resources  
 City, State, ZIP Code: Grainfield, KS 67737 #5 Application Number:

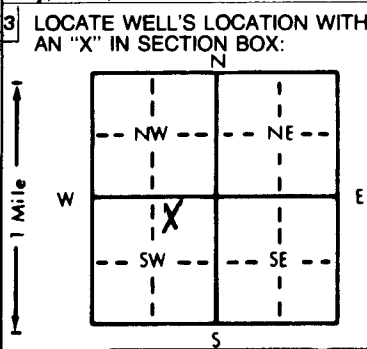

4 DEPTH OF COMPLETED WELL: 140 ft. ELEVATION:  
 Depth(s) Groundwater Encountered 1 ft. 2 ft. 3 ft.  
 WELL'S STATIC WATER LEVEL 116.24 ft. below land surface measured on mo/day/yr  
 Pump test data: Well water was ft. after hours pumping gpm  
 Est. Yield gpm: Well water was ft. after hours pumping gpm  
 Bore Hole Diameter 8 in. to 140 in. to  
 WELL WATER TO BE USED AS: 5 Public water supply 8 Air conditioning 11 Injection well  
 1 Domestic 3 Feedlot 6 Oil field water supply 9 Dewatering 12 Other (Specify below)  
 2 Irrigation 4 Industrial 7 Lawn and garden only 10 Monitoring well  
 Was a chemical/bacteriological sample submitted to Department? Yes No X If yes, mo/day/yr sample was submitted  
 Water Well Disinfected? Yes No X

5 TYPE OF BLANK CASING USED:  
 1 Steel 3 RMP (SR) 5 Wrought iron 8 Concrete tile CASING JOINTS: Glued Clamped  
 2 PVC 4 ABS 6 Asbestos-Cement 9 Other (specify below) Welded  
 7 Fiberglass Threaded X  
 Blank casing diameter 4 in. to 110 ft. Dia in. to ft. Dia in. to ft.  
 Casing height above land surface 0 in. weight 2.071 lbs./ft. Wall thickness or gauge No. .237  
 TYPE OF SCREEN OR PERFORATION MATERIAL:  
 1 Steel 3 Stainless steel 5 Fiberglass 7 PVC 10 Asbestos-cement  
 2 Brass 4 Galvanized steel 6 Concrete tile 9 ABS 11 Other (specify)  
 SCREEN OR PERFORATION OPENINGS ARE:  
 1 Continuous slot 3 Mill slot 5 Gauzed wrapped 8 Saw cut 11 None (open hole)  
 2 Louvered shutter 4 Key punched 6 Wire wrapped 9 Drilled holes  
 7 Torch cut 10 Other (specify)  
 SCREEN-PERFORATED INTERVALS: From 110 ft. to 140 ft. From ft. to ft.  
 From ft. to ft. From ft. to ft.  
 GRAVEL PACK INTERVALS: From 109 ft. to 140 ft. From ft. to ft.  
 From ft. to ft. From ft. to ft.

6 GROUT MATERIAL: 1 Neat cement 2 Cement grout 3 Bentonite 4 Other  
 Grout Intervals: From 109 ft. to 0 ft. From ft. to ft. From ft. to ft.  
 What is the nearest source of possible contamination:  
 1 Septic tank 4 Lateral lines 7 Pit privy 10 Livestock pens 14 Abandoned water well  
 2 Sewer lines 5 Cess pool 8 Sewage lagoon 11 Fuel storage 15 Oil well/Gas well  
 3 Watertight sewer lines 6 Seepage pit 9 Feedyard 12 Fertilizer storage 16 Other (specify below)  
 13 Insecticide storage Removed Fuel Storage  
 Direction from well? How many feet?

FROM	TO	LITHOLOGIC LOG	FROM	TO	PLUGGING INTERVALS
0	2	Surface	111	116	Sandy Clay w/Sand Strks. & Caliche
2	13	Loess			
13	34	Sandy Clay & Caliche	116	127	Fine Med. Sand
34	38	Fine Sand w/Clay	127	136	Clay w/Sand Strks/.
38	39	Cem. Sand w/Caliche & Clay	136	138	Fine Med. Sand
39	44	Tight Silty Sand	138	140	Clay
44	58	Fine Med. Sand w/Clay			
58	70	Tight Fine Sand w/Clay			
70	75	Tight Med. Sand			
75	80	Clay & Caliche w/Cem. Sand			
80	86	Clay			
86	92	Clay, Caliche w/Sand Strks.			
92	97	Fine Med. Sand w/Clay			
97	100	Clay w/Caliche			
100	111	Fine Med. Sand w/Clay & Caliche			

7 CONTRACTOR'S OR LANDOWNER'S CERTIFICATION: This water well was (1) constructed, (2) reconstructed, or (3) plugged under my jurisdiction and was completed on (mo/day/year) 2-5-97 and this record is true to the best of my knowledge and belief. Kansas Water Well Contractor's License No. 554 This Water Well Record was completed on (mo/day/yr) 2-6-97 under the business name of Woofter Pump & Well, Inc. by (signature)

INSTRUCTIONS: Use typewriter or ball point pen. PLEASE PRESS FIRMLY and PRINT clearly. Please fill in blanks, underline or circle the correct answers. Send top three copies to Kansas Department of Health and Environment, Bureau of Water, Topeka, Kansas 66620-0001. Telephone: 913-296-5545. Send one to WATER WELL OWNER and retain one for your records.

OFFICE USE ONLY  
T  
R  
EW  
SEC.  
1/4  
1/4  
1/4