


1 LOCATION OF WATER WELL: Fraction NW 1/4 NE 1/4 SW 1/4 Section Number 7 Township Number T 11 S Range Number R 28 EW
 County: Gove
 Distance and direction from nearest town or city street address of well if located within city?

2 WATER WELL OWNER: Verle Cox
 RR#, St. Address, Box #: P. O. Box 102 Board of Agriculture, Division of Water Resources
 City, State, ZIP Code: Grainfield, KS 67737 #4 Application Number:

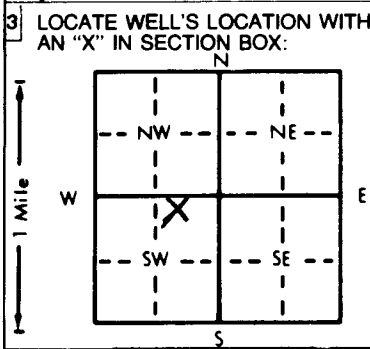

4 DEPTH OF COMPLETED WELL: 140 ft. ELEVATION:
 Depth(s) Groundwater Encountered 1. ft. 2. ft. 3. ft.
 WELL'S STATIC WATER LEVEL 116.7 ft. below land surface measured on mo/day/yr
 Pump test data: Well water was ft. after hours pumping gpm
 Est. Yield gpm: Well water was ft. after hours pumping gpm
 Bore Hole Diameter . . . 8 in. to . . . 140 ft., and in. to ft.
 WELL WATER TO BE USED AS: 5 Public water supply 8 Air conditioning 11 Injection well
 1 Domestic 3 Feedlot 6 Oil field water supply 9 Dewatering 12 Other (Specify below)
 2 Irrigation 4 Industrial 7 Lawn and garden only 10 Monitoring well
 Was a chemical/bacteriological sample submitted to Department? Yes No ; If yes, mo/day/yr sample was sub-
 mitted Water Well Disinfected? Yes No

5 TYPE OF BLANK CASING USED: 5 Wrought iron 8 Concrete tile CASING JOINTS: Glued Clamped
 1 Steel 3 RMP (SR) 6 Asbestos-Cement 9 Other (specify below) Welded
 2 PVC 4 ABS 7 Fiberglass Threaded
 Blank casing diameter . . . 4 in. to . . . 110 ft., Dia in. to ft., Dia in. to ft.
 Casing height above land surface . . . 0 in., weight . . . 2.071 lbs./ft. Wall thickness or gauge No. . . 237
 TYPE OF SCREEN OR PERFORATION MATERIAL: 7 PVC 10 Asbestos-cement
 1 Steel 3 Stainless steel 5 Fiberglass 8 RMP (SR) 11 Other (specify)
 2 Brass 4 Galvanized steel 6 Concrete tile 9 ABS 12 None used (open hole)
 SCREEN OR PERFORATION OPENINGS ARE: 5 Gauzed wrapped 8 Saw cut 11 None (open hole)
 1 Continuous slot 3 Mill slot 6 Wire wrapped 9 Drilled holes
 2 Louvered shutter 4 Key punched 7 Torch cut 10 Other (specify)
 SCREEN-PERFORATED INTERVALS: From 110 ft. to 140 ft., From ft. to ft.
 From ft. to ft., From ft. to ft.
 GRAVEL PACK INTERVALS: From 109 ft. to 140 ft., From ft. to ft.
 From ft. to ft., From ft. to ft.

6 GROUT MATERIAL: 1 Neat cement 2 Cement grout 3 Bentonite 4 Other
 Grout Intervals: From 109 ft. to 0 ft., From ft. to ft., From ft. to ft.
 What is the nearest source of possible contamination:
 1 Septic tank 4 Lateral lines 7 Pit privy 10 Livestock pens 14 Abandoned water well
 2 Sewer lines 5 Cess pool 8 Sewage lagoon 11 Fuel storage 15 Oil well/Gas well
 3 Watertight sewer lines 6 Seepage pit 9 Feedyard 12 Fertilizer storage 16 Other (specify below)
 13 Insecticide storage Removed Fuel Storage
 Direction from well? How many feet?

FROM	TO	LITHOLOGIC LOG	FROM	TO	PLUGGING INTERVALS
0	13	Loess	96	99	Clay
13	35	Clay & Caliche w/Sand Lenses	99	101	Caliche & Clay
35	39	Fine to Med. Sand	101	117	Med. Sand/Clay & Caliche Lns.
39	40	Caliche	117	123	Med. Sand/Clay Lenses
40	44	Tight Silty Sand	123	125	Clay
44	59	Fine to Med. Sand/Clay Lenses	125	132	Med. Tight Sand
59	70	Fine to Med. Sand/Sand Strks.	132	136	Clay
70	74	Cemnted Sand & Caliche	136	140	Med. Sand
74	79	Clay & Caliche Lenses			
79	83	Clay			
83	85	Tight Silty Sand			
85	86	Clay			
86	92	Clay, Caliche & Sand Strks.			
92	96	Med. Sand			

7 CONTRACTOR'S OR LANDOWNER'S CERTIFICATION: This water well was (1) constructed, (2) reconstructed, or (3) plugged under my jurisdiction and was completed on (mo/day/year) . . . 2-4-97 and this record is true to the best of my knowledge and belief. Kansas Water Well Contractor's License No. 554 This Water Well Record was completed on (mo/day/yr) . . . 2-7-97 under the business name of Woofter Pump & Well, Inc. by (signature) *Verle Cox*

INSTRUCTIONS: Use typewriter or ball point pen. PLEASE PRESS FIRMLY and PRINT clearly. Please fill in blanks, underline or circle the correct answers. Send top three copies to Kansas Department of Health and Environment, Bureau of Water, Topeka, Kansas 66620-0001. Telephone: 913-296-5545. Send one to WATER WELL OWNER and retain one for your records.

OFFICE USE ONLY
T
R
E
M
D
SEC.
1/4
1/4
1/4