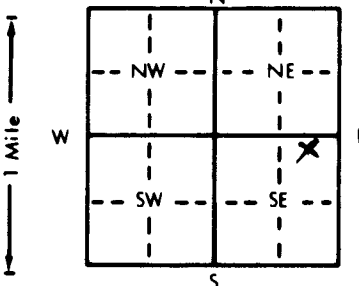


1 LOCATION OF WATER WELL: County: Dove Fraction: EN 1/4 NE 1/4 SE 1/4 Section Number: 5 Township Number: T 11 S Range Number: R 28 E

Distance and direction from nearest town or city street address of well if located within city? 1 East 1/2 North Crown Field Kansas

2 WATER WELL OWNER: Jerome Hoely RR#, St. Address, Box #: RR 18 City, State, ZIP Code: Parry, KS 67751 Board of Agriculture, Division of Water Resources Application Number:

3 LOCATE WELL'S LOCATION WITH AN "X" IN SECTION BOX:  4 DEPTH OF COMPLETED WELL: 120 ft. ELEVATION: 80 ft. below land surface measured on mo/day/yr

Depth(s) Groundwater Encountered 1. \_\_\_\_\_ ft. 2. \_\_\_\_\_ ft. 3. \_\_\_\_\_ ft.  
 WELL'S STATIC WATER LEVEL 80 ft. below land surface measured on mo/day/yr  
 Pump test data: Well water was \_\_\_\_\_ ft. after \_\_\_\_\_ hours pumping \_\_\_\_\_ gpm  
 Est. Yield \_\_\_\_\_ gpm: Well water was \_\_\_\_\_ ft. after \_\_\_\_\_ hours pumping \_\_\_\_\_ gpm  
 Bore Hole Diameter \_\_\_\_\_ in. to \_\_\_\_\_ ft., and \_\_\_\_\_ in. to \_\_\_\_\_ ft.  
 WELL WATER TO BE USED AS:  1 Domestic  2 Irrigation  3 Feedlot  4 Industrial  5 Public water supply  6 Oil field water supply  7 Lawn and garden only  8 Air conditioning  9 Dewatering  10 Monitoring well  11 Injection well  12 Other (Specify below)  
 Was a chemical/bacteriological sample submitted to Department? Yes \_\_\_\_\_ No \_\_\_\_\_; If yes, mo/day/yr sample was submitted \_\_\_\_\_  
 Water Well Disinfected? Yes \_\_\_\_\_ No \_\_\_\_\_

5 TYPE OF BLANK CASING USED:  1 Steel  2 PVC  3 RMP (SR)  4 ABS  5 Wrought iron  6 Asbestos-Cement  7 Fiberglass  8 Concrete tile  9 Other (specify below) CASING JOINTS:  Glued  Clamped  Welded  Threaded  
 Blank casing diameter 16 in. to 120 ft., Dia \_\_\_\_\_ in. to \_\_\_\_\_ ft., Dia \_\_\_\_\_ in. to \_\_\_\_\_ ft.  
 Casing height above land surface 6 ft. below in., weight \_\_\_\_\_ lbs./ft. Wall thickness or gauge No. \_\_\_\_\_

TYPE OF SCREEN OR PERFORATION MATERIAL:  1 Steel  2 Brass  3 Stainless steel  4 Galvanized steel  5 Fiberglass  6 Concrete tile  7 PVC  8 RMP (SR)  9 ABS  10 Asbestos-cement  11 Other (specify)  12 None used (open hole)  
 SCREEN OR PERFORATION OPENINGS ARE:  1 Continuous slot  2 Louvered shutter  3 Mill slot  4 Key punched  5 Gauzed wrapped  6 Wire wrapped  7 Torch cut  8 Saw cut  9 Drilled holes  10 Other (specify)  11 None (open hole)

SCREEN-PERFORATED INTERVALS: From \_\_\_\_\_ ft. to \_\_\_\_\_ ft., From \_\_\_\_\_ ft. to \_\_\_\_\_ ft., From \_\_\_\_\_ ft. to \_\_\_\_\_ ft.  
 GRAVEL PACK INTERVALS: From \_\_\_\_\_ ft. to \_\_\_\_\_ ft., From \_\_\_\_\_ ft. to \_\_\_\_\_ ft., From \_\_\_\_\_ ft. to \_\_\_\_\_ ft.

6 GROUT MATERIAL:  1 Neat cement  2 Cement grout  3 Bentonite  4 Other \_\_\_\_\_  
 Grout intervals: From 9 ft. to 6 ft., From \_\_\_\_\_ ft. to \_\_\_\_\_ ft., From \_\_\_\_\_ ft. to \_\_\_\_\_ ft.  
 What is the nearest source of possible contamination:  10 Livestock pens  11 Fuel storage  12 Fertilizer storage  13 Insecticide storage  14 Abandoned water well  15 Oil well/Gas well  16 Other (specify below)  
 1 Septic tank  2 Sewer lines  3 Watertight sewer lines  4 Lateral lines  5 Cess pool  6 Seepage pit  7 Pit privy  8 Sewage lagoon  9 Feedyard

Direction from well? X 1/2 W 1/2 N How many feet? X \_\_\_\_\_

FROM	TO	LITHOLOGIC LOG	FROM	TO	PLUGGING INTERVALS
			120	50	Clean Sand
			50	9	Top Soil
			9	6	cement
					cut off @ 6 ft. under & welded shut

7 CONTRACTOR'S OR LANDOWNER'S CERTIFICATION: This water well was (1) constructed, (2) reconstructed, or  (3) plugged under my jurisdiction and was completed on (mo/day/year) X June 1988 and this record is true to the best of my knowledge and belief. Kansas Water Well Contractor's License No. \_\_\_\_\_ This Water Well Record was completed on (mo/day/yr) X 2-18-89 under the business name of \_\_\_\_\_ by (signature) X Dale Sath

OFFICE USE ONLY  
T  
R  
EW  
SEC.  
1/4  
1/4  
1/4