


1 LOCATION OF WATER WELL: Fraction NE 1/4 NW 1/4 NE 1/4 Section Number 21 Township Number T 11 S Range Number R 28 EW  
 County: COLE

Distance and direction from nearest town or city street address of well if located within city?  
GRAINFIELD, KANS.

2 WATER WELL OWNER: JAKE ZIMMERMAN  
 RR#, St. Address, Box #: 366 Cedar Box 24  
 City, State, ZIP Code: 67737 Grainfield  
 Board of Agriculture, Division of Water Resources  
 Application Number: none

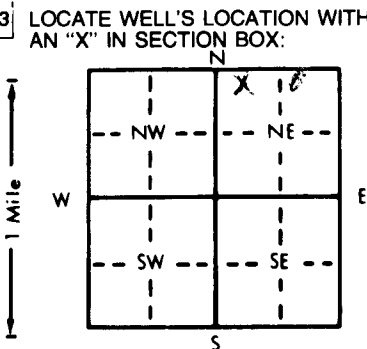

4 DEPTH OF COMPLETED WELL: ..... ft. ELEVATION: .....  
 Depth(s) Groundwater Encountered 1. .... ft. 2. .... ft. 3. .... ft.  
 WELL'S STATIC WATER LEVEL ..... ft. below land surface measured on mo/day/yr .....  
 Pump test data: Well water was ..... ft. after ..... hours pumping ..... gpm  
 Est. Yield ..... gpm: Well water was ..... ft. after ..... hours pumping ..... gpm  
 Bore Hole Diameter ..... in. to ..... ft., and ..... in. to ..... ft.  
 WELL WATER TO BE USED AS:  
 1 Domestic     2 Irrigation     3 Feedlot     4 Industrial  
 5 Public water supply     6 Oil field water supply     7 Lawn and garden only  
 8 Air conditioning     9 Dewatering     10 Observation well  
 11 Injection well     12 Other (Specify below) .....  
 Was a chemical/bacteriological sample submitted to Department? Yes ..... No .....; If yes, mo/day/yr sample was submitted  
 Water Well Disinfected? Yes ..... No .....

5 TYPE OF BLANK CASING USED:  
 1 Steel     2 PVC     3 RMP (SR)     4 ABS     5 Wrought iron     6 Asbestos-Cement     7 Fiberglass  
 Blank casing diameter 5 in. to 8.5 ft., Dia ..... in. to ..... ft., Dia ..... in. to ..... ft.  
 Casing height above land surface ..... in., weight ..... lbs./ft. Wall thickness or gauge No. ....  
 TYPE OF SCREEN OR PERFORATION MATERIAL:  
 1 Steel     2 Brass     3 Stainless steel     4 Galvanized steel     5 Fiberglass     6 Concrete tile     7 PVC     8 RMP (SR)     9 ABS     10 Asbestos-cement     11 Other (specify) .....  
 12 None used (open hole)  
 SCREEN OR PERFORATION OPENINGS ARE:  
 1 Continuous slot     2 Louvered shutter     3 Mill slot     4 Key punched     5 Gauzed wrapped     6 Wire wrapped     7 Torch cut     8 Saw cut     9 Drilled holes     10 Other (specify) .....  
 11 None (open hole)  
 SCREEN-PERFORATED INTERVALS: From ..... ft. to ..... ft., From ..... ft. to ..... ft., From ..... ft. to ..... ft.  
 GRAVEL PACK INTERVALS: From ..... ft. to ..... ft., From ..... ft. to ..... ft., From ..... ft. to ..... ft.

6 GROUT MATERIAL:  1 Neat cement     2 Cement grout     3 Bentonite     4 Other .....  
 Grout intervals: From ..... ft. to ..... ft., From ..... ft. to ..... ft., From ..... ft. to ..... ft.  
 What is the nearest source of possible contamination:  
 1 Septic tank     2 Sewer lines     3 Watertight sewer lines     4 Lateral lines     5 Cess pool     6 Seepage pit     7 Pit privy     8 Sewage lagoon     9 Feedyard     10 Livestock pens     11 Fuel storage     12 Fertilizer storage     13 Insecticide storage     14 Abandoned water well     15 Oil well/Gas well     16 Other (specify below) .....

Direction from well? How many feet?

FROM	TO	LITHOLOGIC LOG	FROM	TO	LITHOLOGIC LOG
5.5	7.0	clean sand			
7.0	4	clay			
4	2	compact			
2	0	top soil			

7 CONTRACTOR'S OR LANDOWNER'S CERTIFICATION: This water well was (1) constructed, (2) reconstructed, or (3) plugged under my jurisdiction and was completed on (mo/day/year) 10-21-87 and this record is true to the best of my knowledge and belief. Kansas Water Well Contractor's License No. .... This Water Well Record was completed on (mo/day/yr) 10-28-87 under the business name of ..... by (signature) Jake Zimmerman  
 INSTRUCTIONS: Use typewriter or ball point pen. PLEASE PRESS FIRMLY and PRINT clearly. Please fill in blanks, underline or circle the correct answers. Send top three copies to Kansas Department of Health and Environment, Bureau of Water Protection, Topeka, Kansas 66620-7320, Telephone: 913-862-9360. Send one to WATER WELL OWNER and retain one for your records.

OFFICE USE ONLY  
T  
R  
EW  
SEC.