


1	LOCATION OF WATER WELL:	Fraction	Section Number	Township Number	Range Number
County:	GOVE	NW $\frac{1}{4}$ SE $\frac{1}{4}$ NW $\frac{1}{4}$	36	11	28 E/W

Distance and direction from nearest town or city street address of well if located within city?
 3 1/2 SOUTH & 3/4 WEST & 1/4 SOUTH OF PARK, KANSAS

2 WATER WELL OWNER: DELORIS PHILIEGER
 RR #, St. Address, Box #: 410 PARKVIEW CT.
 City, State, ZIP Code : QUINTER, KS 66752
 Board of Agriculture, Division of Water Resources
 Application Number:

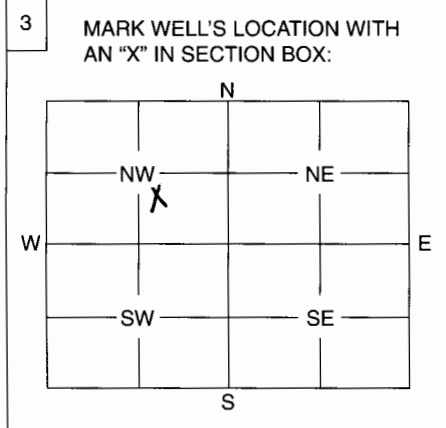

4 DEPTH OF WELL 73 ft.
 WELL'S STATIC WATER LEVEL 51 ft.
 WELL WAS USED AS:
 1 Domestic
 2 Irrigation
 3 Feedlot
 4 Industrial
 5 Public Water Supply
 6 Oil Field Water Supply
 7 Domestic (Lawn & Garden)
 8 Air Conditioning
 9 Dewatering
 10 Monitoring Well
 11 Injection Well
 12 Other

Was a chemical / bacteriological sample submitted to Department? Yes No
 If yes, mo/day/yr sample was submitted

Water Well Disinfected: Yes No

5 TYPE OF BLANK CASING USED:
 1 Steel 3 RMP (SR) 5 Wrought 7 Fiberglass 9 Other (Specify below)
 2 PVC 4 ABS 6 Asbestos-Cement 8 Concrete Tile

Blank casing diameter 12 in. Was casing pulled? Yes No If yes, how much

Casing height above or below land surface 30 BELOW in.

6 GROUT PLUG MATERIAL: 1 Neat cement 2 Cement grout 3 Bentonite 4 Other

Grout Plug Intervals: From 48 ft. to 50 ft., From 0 ft. to 25 ft., From to ft.

What is the nearest source of possible contamination:
 1 Septic tank 6 Seepage pit 11 Fuel storage 16 Other (specify below)
 2 Sewer lines 7 Pit privy 12 Fertilizer storage NONE

3 Watertight sewer lines 8 Sewage lagoon 13 Insecticide storage
 4 Lateral lines 9 Feedyard 14 Abandoned water well
 5 Cess pool 10 Livestock pens 15 Oil well/Gas well

Direction from well? How many feet?

FROM	TO	PLUGGING MATERIALS
0	25	BENTONITE
25	48	SANDY CLAY
48	50	BENTONITE
50	73	SANDY CLAY

7 CONTRACTOR'S OF LANDOWNER'S CERTIFICATION: This water well was plugged under my jurisdiction and was completed on (mo/day/year) 7/20/05 and this record is true to the best of my knowledge and belief. Kansas Water Well Contractor's License No. 489 This Water Well Record was completed on (mo/day/year) 7/21/05 under the business name of AQUA PUMP
 by (signature) Tom M. [Signature]

INSTRUCTIONS: Use typewriter or ball point pen. Please press firmly and print clearly. Please fill in blanks, underline or circle the correct answers. Send top three copies to Kansas Department of Health and Environment, Bureau of Water, Geology Section, 1000 SW Jackson St., Ste. 420, Topeka, Kansas 66612-1367. Telephone: 785/296-5522. Send one to Water Well Owner and retain one for your records.