


USE TYPEWRITER OR BALL POINT PEN—PRESS FIRMLY, PRINT CLEARLY.

WATER WELL RECORD
KSA 82a-1201-1215

Kansas Department of Health and Environment—Division of Environment
(Water well Contractors)
Topeka, Kansas 66620

1. Location of well: County <u>Gove</u> Fraction <u>NW 1/4 NE 1/4 NE 1/4</u> Section number <u>5</u> Township number <u>T 11 S</u> Range number <u>R 28</u> DRL EW	
2. Distance and direction from nearest town or city: <u>East 1/2 North</u> 3. Owner of well: <u>Jerry Goetz</u> Street address of well location if in city: <u>06 Brainfick</u> R.R. or street: City, state, zip code: <u>Park, Ks. 67751</u>	
4. Locate with "X" in section below: Sketch map: <div style="display: flex; align-items: center;"> <div style="margin-right: 10px;"> <p>1 Mile</p> <p>1 Mile</p> </div> <div> <p>6. Bore hole dia. <u>19</u> in. Completion date _____ Well depth <u>175</u> ft. <u>8/29/75</u></p> <p>7. <input type="checkbox"/> Cable tool <input checked="" type="checkbox"/> Rotary <input type="checkbox"/> Driven <input type="checkbox"/> Dug <input type="checkbox"/> Hollow rod <input type="checkbox"/> Jetted <input type="checkbox"/> Bored <input checked="" type="checkbox"/> Reverse rotary</p> <p>8. Use: <input type="checkbox"/> Domestic <input type="checkbox"/> Public supply <input type="checkbox"/> Industry <input checked="" type="checkbox"/> Irrigation <input type="checkbox"/> Air conditioning <input type="checkbox"/> Stock <input type="checkbox"/> Lawn <input type="checkbox"/> Oil field water <input type="checkbox"/> Other</p> <p><input checked="" type="checkbox"/> Casing: Material <u>steel</u> Height: <u>above</u> or below Threaded <input type="checkbox"/> Welded <input checked="" type="checkbox"/> Surface <u>1 1/2</u> in. RMP <input type="checkbox"/> PVC <input type="checkbox"/> Weight _____ lbs./ft. Dia. <u>1 1/2</u> to <u>1 7/8</u> ft. depth Wall Thickness: inches or Dia. _____ in. to _____ ft. depth gage No. _____</p> <p><input checked="" type="checkbox"/> Screen: Manufacturer's name _____ <u>W. A. Brown</u> Type <u>steel</u> Dia. <u>1 3/4 in</u> Slot/gauze <u>1/4</u> Length <u>20 ft.</u> Set between <u>120</u> ft. and <u>175</u> ft. _____ ft. and _____ ft. Gravel pack? <input checked="" type="checkbox"/> Size range of material <u>down</u></p> <p>11. Static water level: _____ mo./day/yr. <u>110</u> ft. below land surface Date <u>8/29/75</u></p> <p>12. Pumping level below land surfaces: _____ ft. after _____ hrs. pumping _____ g.p.m. _____ ft. after _____ hrs. pumping _____ g.p.m. Estimated maximum yield <u>200</u> g.p.m.</p> <p>13. Water sample submitted: _____ mo./day/yr. Yes <input checked="" type="checkbox"/> No <input type="checkbox"/> Date _____</p> <p>14. Well head completion: <input type="checkbox"/> Pileless adapter _____ inches above grade <input checked="" type="checkbox"/> Well grouted? <u>concrete slab</u> With: <input type="checkbox"/> Neat cement <input type="checkbox"/> Bentonite <input type="checkbox"/> Concrete Depth: From _____ ft. to _____ ft.</p> <p><input checked="" type="checkbox"/> Nearest source of possible contamination: ft. _____ Direction _____ Type _____ Well disinfected upon completion? Yes <input type="checkbox"/> No <input type="checkbox"/></p> <p>17. Pump: <input checked="" type="checkbox"/> Not installed Manufacturer's name _____ Model number _____ HP _____ Volts _____ Length of drop pipe _____ ft. capacity _____ g.p.m. Type: <input type="checkbox"/> Submersible <input type="checkbox"/> Turbine <input type="checkbox"/> Jet <input type="checkbox"/> Reciprocating <input type="checkbox"/> Centrifugal <input type="checkbox"/> Other</p> </div> </div>	
5. Type and color of material	
	From To
<u>Silt + clay</u>	<u>0 60</u>
<u>Sandstone + clay</u>	<u>60 112</u>
<u>Sand with clay layers</u>	<u>112 155</u>
<u>Sandstone - Sand</u>	<u>155 175</u>
<u>Yellow clay</u>	<u>175</u>
(Use a second sheet if needed)	
18. Elevation:	19. Remarks:
<p>Topography: <u>Hill</u></p> <p><input checked="" type="checkbox"/> Upland <input type="checkbox"/> Valley</p>	<p>20. Water well contractor's certification: This well was drilled under my jurisdiction and this report is true to the best of my knowledge and belief.</p> <p><u>Aqua Well Drilling</u> 281 Business name License No. Address <u>Gove, Ks. 67736</u> Signed <u>M. Juttla</u> Date <u>6-20-77</u> Authorized representative</p>

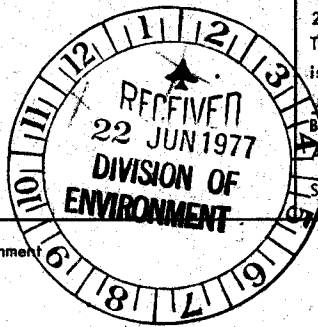

Forward the white, blue and pink copies to the Department of Health and Environment

Form WWC-5