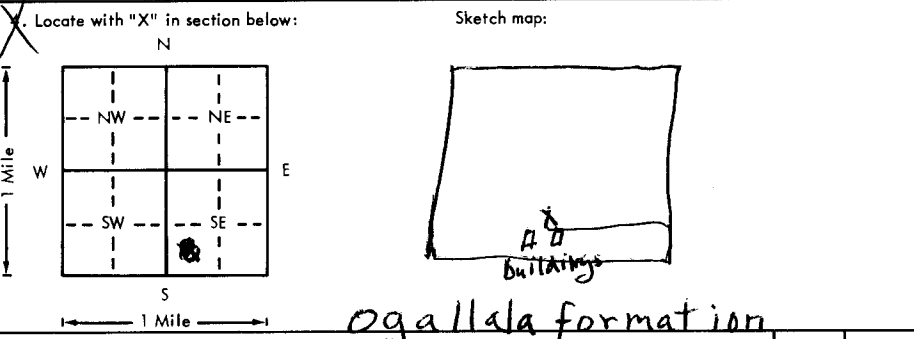


USE TYPEWRITER OR BALL POINT PEN-PRESS FIRMLY, PRINT CLEARLY.

WATER WELL RECORD
KSA 82a-1201-1215

Kansas Department of Health and Environment-Division of Environment
(Water well Contractors)
Topeka, Kansas 66620

1. Location of well: County Gove Section SW 1/4 SE 1/4 SE 1/4 Section number 10 Township number T 11 S R 28 Range number 28 DR/L EW	
2. Distance and direction from nearest town or city: 2 3/4 West 1/4 North of Park 3. Owner of well: Dave Hartman R.R. or street: Park Ks. City, state, zip code: 67751	
4. Locate with "X" in section below: Sketch map: 	
5. Type and color of material	
	From To
silt	0 15
clay	15 60
sandstone + clay	60 100
sand + gravel	100 140
shale	140
6. Bore hole dia. 8 in. Completion date 1/30/75 Well depth 140 ft.	
7. <input type="checkbox"/> Cable tool <input checked="" type="checkbox"/> Rotary <input type="checkbox"/> Driven <input type="checkbox"/> Dug <input type="checkbox"/> Hollow rod <input type="checkbox"/> Jetted <input type="checkbox"/> Bored <input type="checkbox"/> Reverse rotary	
8. Use: <input type="checkbox"/> Domestic <input type="checkbox"/> Public supply <input type="checkbox"/> Industry <input type="checkbox"/> Irrigation <input type="checkbox"/> Air conditioning <input checked="" type="checkbox"/> Stock <input type="checkbox"/> Lawn <input type="checkbox"/> Oil field water <input type="checkbox"/> Other	
9. Casing: Material ptls Height: above or below Threaded <input type="checkbox"/> Welded <input checked="" type="checkbox"/> Surface 12 in. RMP <input type="checkbox"/> PVC <input checked="" type="checkbox"/> Weight <input type="checkbox"/> lbs./ft. Dia. 5 in. to 140 ft. depth Wall Thickness: inches or Dia. <input type="checkbox"/> in. to <input type="checkbox"/> ft. depth gage No. 330	
10. Screen: Manufacturer's name Peerless Plastics Type PVC Dia. 5 in. Slot/gauze 1/16 Length 20 ft. Set between 120 ft. and 140 ft. Gravel pack? <input checked="" type="checkbox"/> Size range of material 1/4 down	
11. Static water level: 90 ft. below land surface Date 1/30/75	
12. Pumping level below land surfaces: ____ ft. after ____ hrs. pumping ____ g.p.m. ____ ft. after ____ hrs. pumping ____ g.p.m. Estimated maximum yield ____ g.p.m.	
13. Water sample submitted: ____ mo./day/yr. Yes <input type="checkbox"/> No <input checked="" type="checkbox"/> Date ____	
14. Well head completion: <input type="checkbox"/> Pitless adapter ____ inches above grade	
15. Well grouted? yes With clay Neat cement <input type="checkbox"/> Bentonite <input type="checkbox"/> Concrete <input type="checkbox"/> Depth: From 0 ft. to 20 ft.	
16. Nearest source of possible contamination: ____ Direction ____ Type ____ Well disinfected upon completion? Yes <input type="checkbox"/> No <input checked="" type="checkbox"/>	
17. Pump: <input checked="" type="checkbox"/> Not installed Manufacturer's name ____ Model number ____ HP ____ Volts ____ Length of drop pipe ____ ft. capacity ____ g.p.m. Type: <input type="checkbox"/> Submersible <input type="checkbox"/> Turbine <input type="checkbox"/> Jet <input type="checkbox"/> Reciprocating <input type="checkbox"/> Centrifugal <input type="checkbox"/> Other	
(Use a second sheet if needed)	
18. Elevation: Topography: <input type="checkbox"/> Hill <input checked="" type="checkbox"/> Slope <input type="checkbox"/> Upland <input type="checkbox"/> Valley	19. Remarks:
20. Water well contractor's certification: This well was drilled under my jurisdiction and this report is true to the best of my knowledge and belief. Aqua Well Drilling 281 Business name License No. ____ Address Gove, Ks. 67736 Signed J. M. Inettle Date 6-20-77 Authorized representative	

Forward the white, blue and pink copies to the Department of Health and Environment

Form WWC-5